



City of Belle Isle
 Universal Engineering Sciences 3532 Maggie Blvd., Orlando, FL 32811
 Tel 407-581-8161 * Fax 407-581-0313 * www.universalengineering.com

PERMIT CARD - PLEASE POST AT JOB SITE

THIS DOCUMENT BECOMES YOUR PERMIT WHEN PROPERLY VALIDATED

Per FBC 105.3.3: An enforcing authority may not issue a building permit for any building construction, erection, alteration, modification, repair or addition unless the permit either includes on its face or there is attached to the permit the following statement: **"NOTICE: In addition to the requirements of this permit, there may be additional restrictions applicable to this property that may be found in the public records of this county, and there may be additional permits required from other governmental entities such as water management districts, state agencies, or federal agencies."** The issuance of this permit does not grant permission to violate any applicable City, Orange County, State of Florida and/or Federal codes and/or ordinances. Separate permits are required for Signs, Roofing, Electrical, Gas, Plumbing and Mechanical services. This permit becomes VOID if the work authorized is not commenced within 6 months, or is suspended or abandoned for a period of 6 months after commencement. **WORK SHALL BE CONSIDERED SUSPENDED IF AN APPROVED INSPECTION HAS NOT BEEN MADE WITHIN A 6 MONTH PERIOD.** PERMISSION IS GRANTED TO DO THE FOLLOWING WORK ACCORDING TO THE CONDITIONS HEREON AND THE APPROVED PLANS AND SPECIFICATIONS, SUBJECT TO COMPLIANCE WITH THE ORDINANCES OF THE CITY OF BELLE ISLE, FLORIDA.

Scope of Work: DOOR: size-for-size

Comments: None

Project Information

Address: 7157 Conway Circle, Belle Isle, FL 32809
Parcel ID: 25-23-29-5884-15-130
Property Owner: Stewart, Pamela
Phone Number: None

Company Name: The Home Depot At-Home Services
Contractor Name: Ramdial, Boysie Ganga
License Number: CRC046858
Address: 207 Kolsey Lane, Suite K, Tampa, FL 33619
Phone Number: 813-402-3700

Permit Number: 2014-12-006

Date of Application: 12/09/2013

Date Permit Issued: 12/19/2013

WARNING TO OWNER: "YOUR FAILURE TO RECORD A NOTICE OF COMMENCEMENT MAY RESULT IN YOU PAYING TWICE FOR IMPROVEMENTS TO YOUR PROPERTY. IF YOU INTEND TO OBTAIN FINANCING, CONSULT WITH YOUR LENDER OR AN ATTORNEY BEFORE RECORDING YOUR NOTICE OF COMMENCEMENT." ON THE JOB INSPECTION(S) MUST BE MADE BEFORE PROCEEDING WITH SUBSEQUENT WORK. THIS CARD MUST BE DISPLAYED OUTSIDE AND BE PROTECTED FROM THE WEATHER WHILE BEING VISIBLE FROM THE STREET UNTIL THE FINAL INSPECTIONS HAVE BEEN APPROVED.

BUILDING FEATURES

IMPACT FEES

School \$
 Traffic \$

ZONING FEES

Zoning Fee \$

UNIVERSAL ENG - BUILDING FEES

Cert of Occ \$
 Demo \$
 Building \$
 Fence \$
 Driveway \$
 Shed \$
 Window(s) \$
 Door(s) \$43.50
 PrePower \$
 Electrical \$
 Temp Pole \$
 Plumbing \$
 Mechanical \$
 Gas \$
 Roofing \$
 Boat Dock \$
 Screen Encl \$
 Swimming Pool \$
 Sign \$

SURCHARGE FEES

Surcharge Fee \$2.00
 Surcharge Fee \$2.00

TOTAL FEES \$47.50

Date Paid 1-3-14

CC or Check # mc 6101

Amount Paid 47.50

The person accepting this permit shall conform to the terms of the application on file and construction shall conform to the requirements of the Florida Building Code (F S 553).

BUILDING INSPECTOR USE ONLY

IF APPLICABLE:

Have Zoning Approval Conditions Been Met? YES NO Have Stormwater Approval Conditions Been Met? YES NO Silt fencing in place? YES NO Turbidity Barrier in place? YES NO

BUILDING

1st _____ (Footing/Foundation)

Survey specific foundation plan must be onsite before slab pour. Approved Plan on Site? _____

2nd _____ (Slab)

3rd _____ (Lintel)(Wall Reinforcing on Masonry Building)

4th _____ (Exterior Framing)(Roof/Wall Sheathing)

5th _____ (Framing) (To be made after Plumbing/ Mechanical/ Electrical Rough-Ins & Windows/Doors Installed)

6th _____ (Insulation to be Made After Roof Installed)

7th _____ (Drywall)

8th _____ (Sidewalk/Driveway)

9th _____ (Other)

10th _____ (Final - After MEP and Other Applicable Finals)

ROOFING

1st ROOFING Deck Nailing/Dry-in/Flashing _____

2nd ROOFING Covering In-Progress _____

3rd ROOFING Covering Final _____

PLUMBING (Pool-Piping, Solar, Irrigation, Water Treatment Equip, Etc...)

1st _____ (Underground) 2nd _____ (Sewer)

3rd _____ (Rough-In/Tub Set) 4th _____ (Final)

CHECK APPROPRIATE BOX

GAS ___ Natural ___ LP MECHANICAL ELECTRICAL LOW VOLTAGE

1st _____ (Rough-In) 2nd _____ (Final)

Inspection requests are to be emailed to BI scheduling@UniversalEngineering.com; a confirmation email will be sent back to you upon scheduling. Next-Day inspection requests must be made by 1pm. Please include the following in your request: Permit #, project address, type of inspection, date of the requested inspection, a contact name & a contact phone number. AM or PM may be requested but cannot be guaranteed.

For a copy of your permit, or to check inspection results, please visit <https://universalengineering.sharefile.com/ff094edc4-832d-44bd-9809-ecf32f9e2e63>

login ID = cobi@universalengineering.com

password = universal113



City of Belle Isle
 1600 Nela Avenue, Belle Isle, FL 32809
 Tel 407-851-7730 * Fax 407-240-2222 * www.cityofbelleislefl.org
Building Permit (Land Use) Application

Received
 12-9-13

DATE: _____ PERMIT # 2014-12-006

PROJECT ADDRESS 7157 Conway Cir. Belle Isle, FL X 32809 32812 9770

PROPERTY OWNER Pamela Stewart PHONE _____ VALUE OF WORK (labor & material) \$ 1813.00 1813

PLEASE LIST THE NATURE OF YOUR PROPOSED IMPROVEMENTS

replace 1 door size for size and 12 windows size for size See attached

- Please provide information, if applicable.
- Survey specific foundation plan required to show compliance with zoning setbacks
- BOAT DOCK: DEP Clearance Required with Application (Call 407-897-4100); please provide a copy of their report
- PROVIDE SEPTIC RESIDENTIAL SYSTEM VERIFICATION - OC DOCUMENT 64E-6, FOR NEW / ALTERED / ADDITIONS to Septic System
- Homeowners will be required to have a contractor on record for homes that are rented and/or not homestead

Please Complete for the City of Belle Isle Zoning Review: Parcel Id Number: 25-23-29-5884-15-130
 To obtain this information, please visit: <http://www.ocpafl.org/Searches/ParcelSearch.aspx>

SPECIAL CONDITIONS: STRUCTURES MAY NOT ENCROACH INTO ANY EASEMENT OR REQUIRED SETBACK. Note, this Zoning Approval MAY or MAY NOT be in conflict with your Deed Restrictions. For New Single Family Residence, a Traffic Impact Fee and School Impact will be assessed.

Attached Survey _____ SETS and Construction Plans _____ SETS

PLANNING & ZONING APPROVAL: _____ DATE _____

PLEASE COMPLETE for Building Review

CONSTRUCTION TYPE _____ Res: _____ Single Fam _____ Multi Fam _____

OCCUPANCY GROUP _____ Comm _____ #STORIES _____ TOTAL SQ.FT. _____

#BLDG. _____ #UNITS _____ #STORIES _____

MAX. FLOOR LOAD _____ MAX. OCCUPANCY _____

MIN. FLOOR ELEV. _____ LOW FLOOR ELEV. _____

WATER SERVICE _____ WELL _____ SEPTIC _____

BUILDING REVIEWER _____ DATE _____

NOTES 25
14
25 + 14.50
61 + 20.50

Per FSS 105.3.3: 25 + 14.50 = 40
25 + 35 = 60
61 + 20.50 = 81.50

An enforcing authority may not issue a building permit for any building construction, erection, alteration, modification, repair or addition unless the permit either includes on its face or there is attached to the permit the following statement: "NOTICE: In addition to the requirements of this permit, there may be additional restrictions applicable to this property that may be found in the public records of this county, and there may be additional permits required from other governmental entities such as water management districts, state agencies, or federal agencies."

Waste Management is by legal contract the sole authorized provider of garbage, recycling, yard waste, and commercial garbage and construction debris collection and disposal services with the city limits of the City. Contractors, homeowners and commercial businesses may contact Waste Management at 407-788-0800 to setup accounts for Commercial, Construction Roll Off, or other services needed. Rates are fixed by contract and are available at City Hall or from Waste Management. The City enforces the contract through its code enforcement office. Failure to comply will result in a stop work order.

Wind Load Category: A ___ B ___ C ___ D ___

SPRINKLERS REQ'D	Y	N
If Required - SUBMIT COPY OF PLANS FOR FIRE REVIEW		Date: Sent _____ RCD _____
ZONING	Y	\$ _____
CERT OF OCC	Y	\$ _____
TRAFFIC	Y	\$ _____
SCHOOL	Y	\$ _____
FIRE	Y	\$ _____
SWIMMING POOL	Y	\$ _____
POOL ENCLOSURE	Y	\$ _____
BOAT DOCK	Y	\$ _____
BUILDING	Y	\$ _____
<u>WINDOWS</u>	<u>Y</u>	\$ <u>21.50</u>
DOOR(S)	N	\$ _____
OTHER	Y	\$ _____

3% FL SURCHARGE 4.00

TOTAL 95.50 + 11.50 = 107.00

By Owner Form NA
 Notice of Commencement Y
 Power of Attorney Y
 Contractor Packet On File? Y

OTHER PERMITS REQUIRED:

ELECTRICAL Y NA
 PREPOWER Y NA
 MECHANICAL Y NA
 PLUMBING Y NA
 ROOFING Y NA
 GAS Y NA
 OTHER: _____



City of Belle Isle
 1600 Nele Avenue, Belle Isle, FL 32809
 Tel 407-851-7730 * Fax 407-240-2222 * www.cityofbelleisle.org

Stewart

received
 12-19-13

Building Permit (Land Use) Application
 To be completed as required by State Statute Section 713 and other applicable sections.

PERMIT # _____

Owner's Name Emela Stewart
 Owner's Address 7157 Conway Cir. Orlando, FL, 32809

Fee Simple Titleholder's Name (if other than owners) _____

Address	City	State	Zip Code
Contractor's Name <u>The Home Depot of Home Services</u>	Architect/Engineer's Name		
Contractor's Address <u>207 Kolsey Ln. Ste. K</u>	Architect/Engineer's Address		
City, State, ZIP <u>Tampa, FL, 33619</u>	City, State, ZIP		
License # <u>CRC046858</u>	License #		
Contact Phone/Cell <u>013-402-3700</u>	Contact Phone/Cell		
Contact Email <u>held_bishop@homedepot.com</u>	Contact Email		

WARNING TO OWNER: Your failure to record a Notice of Commencement may result in your paying twice for improvements to your property. A notice of commencement must be recorded if job is \$26000(+) or if A/C Replacement \$7600(+) and posted on the job site before the first inspection. If you intend to obtain financing, consult with your lender or an attorney before recording your Notice of Commencement.

I hereby make Application for Permit as outlined above, and if same is granted I agree to conform to all Division of Building Safety Regulations (www.dorflabuilding.org) and City Ordinances (www.municode.com) regulating same and in accordance with plans submitted. The issuance of this permit does not grant permission to violate any applicable City and/or State of Florida codes and for ordinances. Application is hereby made to obtain a permit to do the work and installations as indicated. I certify that no work or installation has commenced prior to the issuance of a permit and that all work will be performed to meet the standards of all laws regulating construction in this jurisdiction. I understand that a separate permit must be secured for all other construction including ELECTRICAL, MECHANICAL, PLUMBING, GAS, SIGNS, POOLS, ENCLOSURES, ETC.

OWNER'S AFFIDAVIT: I certify that all the foregoing information is accurate and that all work will be done in compliance with all applicable laws regulating construction and zoning.

Owner Signature Emela Stewart
 The foregoing instrument was acknowledged before me this 12/15/13
 by Emela Stewart who is personally known to me
 and who produced FIDL
 as identification and who did not take an oath.
 Myself as to Owner
 State of Florida
 County of Orange
 Notary Signature Boysie Ramdial
 COMPANY NAME THE HOME DEPOT HOME SERV.
 The foregoing instrument was acknowledged before me this 12/06/13
 by BOYSIE RAMDIAL who is personally known to me
 and who produced _____
 as identification and who did not take an oath.
 Notary as to Owner
 State of Florida
 County of Orange



STATE OF FLORIDA
 Comm# FF055234
 Expires 9/18/2017

ERICK A DE DIOS
 MY COMMISSION # EE049836
 EXPIRES December 16, 2014
 FloridaNotaryService.com
 (807) 508-0153

<p>Impervious Surface Ratio Worksheet Development Zoned A-1, A-2, R-1-AAA, R-1-AA, R-1-A, R-1 per Section 50-74 Impervious Surface Ratio of the City Code</p> <p>1. Total Lot Area (sqft) X 0.35 = Allowable Impervious Area (BASE) Total Lot Area _____ X 0.35 = _____ Allowable Impervious Area (BASE) _____</p> <p>2. Calculate the "proposed" impervious area on the lot. This includes the sum of all areas that do not allow direct percolation of rainwater. Examples include house, pool, deck, driveway, accessory building, etc</p> <ul style="list-style-type: none"> House _____ Driveway _____ Walkway _____ Accessory Buildings _____ Pool & Spa _____ Deck & Patio _____ Other _____ <p>Actual Impervious Area (AJA) _____</p> <p>3. If AJA is less than BASE, subtract AJA from BASE to determine the amount of Impervious area that may be added without providing onsite retention.</p> <p>4. If AJA is greater than BASE, then onsite retention must be provided. Assuming 7.5 inches of rainfall based on a 24hr. 10 year Rain Event (TP-40), the formula is: (7.5 inches rainfall/12 inches pifoot) X (result from line 4) = cubic feet of storage volume needed</p>	<p>Impervious Surface Ratio Worksheet Development Zoned A-1, A-2, R-1-AAA, R-1-AA, R-1-A, R-1 per Section 50-74 Impervious Surface Ratio of the City Code</p> <p>1. Total Lot Area (sqft) X 0.35 = Allowable Impervious Area (BASE) Total Lot Area _____ X 0.35 = _____ Allowable Impervious Area (BASE) _____</p> <p>2. Calculate the "proposed" impervious area on the lot. This includes the sum of all areas that do not allow direct percolation of rainwater. Examples include house, pool, deck, driveway, accessory building, etc</p> <ul style="list-style-type: none"> House _____ Driveway _____ Walkway _____ Accessory Buildings _____ Pool & Spa _____ Deck & Patio _____ Other _____ <p>Actual Impervious Area (AJA) _____</p> <p>3. If AJA is less than BASE, subtract AJA from BASE to determine the amount of Impervious area that may be added without providing onsite retention.</p> <p>4. If AJA is greater than BASE, then onsite retention must be provided. Assuming 7.5 inches of rainfall based on a 24hr. 10 year Rain Event (TP-40), the formula is: (7.5 inches rainfall/12 inches pifoot) X (result from line 4) = cubic feet of storage volume needed</p>
--	--

RETAIN ORIGINAL AT CITY HALL - Use as of 06/20/12 FORM/LANDHOUSE02 - 2 of 2 Page Form

CHRIS GIROUX
 NOTARY PUBLIC
 STATE OF FLORIDA
 Comm# FF050849
 Expires 9/3/2017

CITY OF BELLE ISLE
Permit Application Review Sheet

Permit Number	2014-12-006
Property Owner	Stewart
Address	7157 Conway Cir
Nature of Improvement	Door / Windows
Received Application	12-9-13
Sent for Stormwater Review	
Stormwater Approved	
Sent for Zoning Review	
Zoning Approved	
Applied for Variance	
Variance Approved	
Sent to BO for Review	
Building Official Approved	
Comments	
1.	12-9-13 sq app missing owners signature; emailed Heidi
2.	12-19-13 sq need signed app; wtg on FPA docs...need
3.	1-3-14 sq Jon revised app + deleted windows.
4.	
5.	
6.	
7.	
8.	
9.	
10.	
11.	
12.	



To Whom It May Concern:

This letter will authorize the following person(s) to act as agent(s) on behalf of THD At-Home Services, INC, D/B/A The Home Depot At-Home Services, 2690 Cumberland Pkwy SE, Suite 300, Atlanta, GA 30339 to sign or pull for permits and inspections with respect to the installation, maintenance and repair of windows, siding, and fencing under Florida State Residential Contractor license number CRC046858.

Authorized person(s):

- Brian Kirby
- Tim O'Malley
- Christine O'Malley
- Dennis Godsey
- Elizabeth Hutchinson
- John Hutchinson
- Don Kirby
- Gary Barson
- Jon Thomas
- Erick DeDios
- Aaron Hallich

OWNER: PAMELA STEWARD
 ADDRESS: 7157 CONWAY CIR
 BELLE ISLE FL 32809

Boysie L. Ramdial

Qualifier – Boysie Ramdial
 THD At-Home Services, INC
 The Home Depot At-Home Services

STATE OF FLORIDA
 COUNTY OF HILLSBOROUGH

The foregoing instrument was acknowledged before me this 3 day of Dec 2013 by Boysie Ramdial.

[Signature]
 Notary Public – State of Florida

Jonathon Thomas
 Printed Name



My Commission Expires _____

Personally known x or Produced Identification _____

THD At-Home Services, Inc.
 207 Kelsey Lane • Suite K • Tampa, FL 33619
 Phone: 813-402-3700 • Fax: 813-630-4112 • Toll Free: 855-729-6002



BCIS Home | Log In | User Registration | Hot Topics | Submit Surcharge | Stats & Facts | Publications | FBC Staff | BCIS Site Map | Links | Search

License efficiency. Regulate fairly.

OFFICE OF THE SECRETARY

Product Approval Menu > Product or Application Search > Application List > Application Detail

FL # FL253-R12
 Application Type Revision
 Code Version 2010
 Application Status Approved

*Approved by DBPR. Approvals by DBPR shall be reviewed and ratified by the POC and/or the Commission if necessary.

Comments Archived

Product Manufacturer Address/Phone/Email

PGT Industries
 1070 Technology Drive
 Nokomis, FL 34275
 (941) 486-0100 Ext 22318
 druark@pgtindustries.com

Authorized Signature

Jens Rosowski
 jrosowski@pgtindustries.com

Technical Representative Address/Phone/Email

Jens Rosowski
 1070 Technology Drive
 Nokomis, FL 34275
 (941) 486-0100 Ext 21140
 jrosowski@pgtindustries.com

Quality Assurance Representative Address/Phone/Email

Category Subcategory

Exterior Doors
 Swinging Exterior Door Assemblies

Compliance Method

Certification Mark or Listing

Certification Agency Validated By

Miami-Dade BCCO - CER
 Miami-Dade BCCO - VAL

Referenced Standard and Year (of Standard)

Standard TAS 201, 202, 203
 Year 1994

Equivalence of Product Standards Certified By

Product Approval Method

Method 1 Option A

Date Submitted 01/24/2013
 Date Validated 01/25/2013
 Date Pending FBC Approval
 Date Approved 02/04/2013

Summary of Products

FL #	Model, Number or Name	Description
253.1	FD-101 (Impact)	WingGuard Outswing Aluminum French Door with or without Sidelites Certification Agency Certificate FL253 R12 C CAC 12-0516.02.pdf Quality Assurance Contract Expiration Date 10/18/2017 Installation Instructions FL253 R12 II 12-0516.02.pdf Verified By: Miami-Dade BCCO - CER Created by Independent Third Party: Evaluation Reports Created by Independent Third Party:
253.2	FD-101 (Non-Impact)	Outswing Aluminum French Door with or without Sidelites
253.3	FD-650 (Non-Impact)	Certification Agency Certificate FL253 R12 C CAC 12-0516.03 NON.pdf Quality Assurance Contract Expiration Date 08/02/2017 Installation Instructions FL253 R12 II 12-0516.03 NON.pdf Verified By: Miami-Dade BCCO - CER Created by Independent Third Party: Evaluation Reports Created by Independent Third Party:
253.4	FD-750 (Impact)	WingGuard Outswing Aluminum French Door with or without Sidelites
253.5	SE-3550 (Impact)	Aluminum Outswing Storefront Door with or without Transom
253.1	FD-101 (Impact)	Certification Agency Certificate FL253 R12 C CAC 11-1013.23.pdf Quality Assurance Contract Expiration Date 03/24/2015 Installation Instructions FL253 R12 II 11-1013.23.pdf Verified By: Miami-Dade BCCO - CER Created by Independent Third Party: Evaluation Reports Created by Independent Third Party:
253.2	FD-101 (Non-Impact)	Outswing Aluminum French Door with or without Sidelites
253.3	FD-650 (Non-Impact)	Certification Agency Certificate FL253 R12 C CAC 11-1013.23.pdf Quality Assurance Contract Expiration Date 03/24/2015 Installation Instructions FL253 R12 II 11-1013.23.pdf Verified By: Miami-Dade BCCO - CER Created by Independent Third Party: Evaluation Reports Created by Independent Third Party:
253.4	FD-750 (Impact)	WingGuard Outswing Aluminum French Door with or without Sidelites
253.5	SE-3550 (Impact)	Aluminum Outswing Storefront Door with or without Transom
253.1	FD-101 (Impact)	Certification Agency Certificate FL253 R12 C CAC 12-1005.02.pdf Quality Assurance Contract Expiration Date 01/17/2018 Installation Instructions FL253 R12 II 12-1005.02.pdf Verified By: Miami-Dade BCCO - CER Created by Independent Third Party: Evaluation Reports Created by Independent Third Party:
253.2	FD-101 (Non-Impact)	Outswing Aluminum French Door with or without Sidelites
253.3	FD-650 (Non-Impact)	Certification Agency Certificate FL253 R12 C CAC 12-1005.02.pdf Quality Assurance Contract Expiration Date 01/17/2018 Installation Instructions FL253 R12 II 12-1005.02.pdf Verified By: Miami-Dade BCCO - CER Created by Independent Third Party: Evaluation Reports Created by Independent Third Party:
253.4	FD-750 (Impact)	WingGuard Outswing Aluminum French Door with or without Sidelites
253.5	SE-3550 (Impact)	Aluminum Outswing Storefront Door with or without Transom

[Back](#) [Next](#)

Contact Us :: [1940 North Monroe Street, Tallahassee, FL 32399](#) Phone: [850-487-1824](#)

The State of Florida is an AA/EEO employer. [Copyright 2007-2013 State of Florida](#). :: [Privacy Statement](#) :: [Accessibility Statement](#) :: [Refund Statement](#)
Under Florida law, email addresses are public records. If you do not want your e-mail address released in response to a public-records request, do not send electronic mail to this entity. Instead, contact the office by phone or by traditional mail. If you have any questions, please contact 850.487.1395
*Pursuant to Section 455.275(1), Florida Statutes, effective October 1, 2012, licensees licensed under Chapter 455, F.S. must provide the Department with an email address; if they have one. The emails provided may be used for official communication with the licensee. However email addresses are public record. If you do not wish to supply a personal address, please provide the Department with an email address which can be made available to the public. To determine if you are a licensee under Chapter 455, F.S., please click [here](#).

Product Approval Accepts:



http://www.floridabuilding.org/pr/pr_app_dtl.aspx?param=wGEVXQwtDqvweIwRFXRvH... 1/3/2014



MIAMI-DADE COUNTY
 DEPARTMENT OF PERMITTING, ENVIRONMENT, AND REGULATORY
 AFFAIRS (PERA)
 BOARD AND CODE ADMINISTRATION DIVISION
NOTICE OF ACCEPTANCE (NOA)

MIAMI-DADE COUNTY
 PRODUCT CONTROL SECTION
 11805 SW 26 Street, Room 208
 Miami, Florida 33175-2474
 T (786) 315-2590 F (786) 315-2599
www.miamidadade.gov/pera/

PGT Industries
 1070 Technology Drive
 North Venice, FL 34275

SCOPE:

This NOA is being issued under the applicable rules and regulations governing the use of construction materials. The documentation submitted has been reviewed and accepted by Miami-Dade County PERA -Product Control Section to be used in Miami Dade County and other areas where allowed by the Authority Having Jurisdiction (AHJ).

This NOA shall not be valid after the expiration date stated below. The Miami-Dade County Product Control Section (In Miami Dade County) and/or the AHJ (in areas other than Miami Dade County) reserve the right to have this product or material tested for quality assurance purposes. If this product or material fails to perform in the accepted manner, the manufacturer will incur the expense of such testing and the AHJ may immediately revoke, modify, or suspend the use of such product or material within their jurisdiction. PERA reserves the right to revoke this acceptance, if it is determined by Miami-Dade County Product Control Section that this product or material fails to meet the requirements of the applicable building code.

This product is approved as described herein, and has been designed to comply with the Florida Building Code, including the High Velocity Hurricane Zone.

DESCRIPTION: Series "FD-101" Outswing Aluminum French Door w/ Sidelites – Non-Impact

APPROVAL DOCUMENT: Drawing No. 11005-2 Rev C, titled "Outswing Non-Impact French door(s) & Sidelite(s)", sheets 1 through 11 of 11, prepared by manufacturer, dated 02/28/07 and last revised on 10/11/11, signed and sealed by Lynn Miller, P.E., bearing the Miami-Dade County Product Control Revision stamp with the Notice of Acceptance number and expiration date by the Miami-Dade County Product Control Section.

MISSILE IMPACT RATING: None: Approved Hurricane Protection devices, complying w/ FBC, as applicable are required.

Limitations:

1. Use of Table 1 or 2 (sheet 1) requires full length reinforcements (item # 22) for OX, XO, XXO, OXX, OXO and OXXO configurations. The lower design pressure from table 1 or table 2 shall control.
2. Egress operable doors must comply with min clear width per FBC, as applicable.
3. Nominal ¼" max. airspace is applicable for I.G. glazing with spacer item # 102.

LABELING: Each unit shall bear a permanent label with the manufacturer's name or logo, city, state and series and following statement: "Miami-Dade County Product Control Approved", noted herein.

RENEWAL of this NOA shall be considered after a renewal application has been filed and there has been no change in the applicable building code negatively affecting the performance of this product.

TERMINATION of this NOA will occur after the expiration date or if there has been a revision or change in the materials, use, and/or manufacture of the product or process. Misuse of this NOA as an endorsement of any product, for sales, advertising or any other purposes shall automatically terminate this NOA. Failure to comply with any section of this NOA shall be cause for termination and removal of NOA.

ADVERTISEMENT: The NOA number preceded by the words Miami-Dade County, Florida, and followed by the expiration date may be displayed in advertising literature. If any portion of the NOA is displayed, then it shall be done in its entirety.

INSPECTION: A copy of this entire NOA shall be provided to the user by the manufacturer or its distributors and shall be available for inspection at the job site at the request of the Building Official. This NOA renews NOA # 11-1013.21 and consists of this page 1 and evidence pages E-1, as well as approval document mentioned above.

The submitted documentation was reviewed by **Ishaq I. Chanda, P.E.**



12/12/17

NOA No 12-0516.03
 Expiration Date: August 02, 2017
 Approval Date: August 02, 2012
 Page 1

NOTICE OF ACCEPTANCE: EVIDENCE SUBMITTED

A. DRAWINGS

1. Manufacturer's die drawings and sections (submitted under file # **11-1013.21**).
2. Drawing No. **11005-2 Rev C**, titled "Outswing Non-Impact French door(s) & Sidelite(s)", sheets 1 through 11 of 11, prepared by manufacturer, dated 02/28/07 and last revised on 10/11/11, signed and sealed by Lynn Miller, P.E.

A. TESTS (submitted under file # **11-1013.21**)

- Test report on
- 1) Air Infiltration Test, per FBC, TAS 202-94
 - 2) Uniform Static Air Pressure Test, per FBC, TAS 202-94
 - 3) Water Resistance Test, per FBC, TAS 202-94.
 - 4) Forced Entry Test, per FBC 2411 3.2.1 (b) and TAS 202-94

Along with marked-up drawings and installation diagram of aluminum out swinging French door w/ sidelites, prepared by Fenestration Testing Laboratory, Inc., Test Report No(s). **FTL-4964**, dated September 09, 2006, signed and sealed by Edmundo Largaespada, P.E.

C. CALCULATIONS (submitted under file # **11-1013.21**)

1. Statement letter dated OCT 11, 2011, compliance to FBC 2007 & FBC 2010, prepared by PGT, signed & sealed by Lynn Miller, P.E.
2. Statement letter dated 10/07/11, Successor Engineer adopting the another engineer's work per FAR 61G15-27-001, signed & sealed by Lynn Miller, P.E.
3. Anchor verification and comparative analysis dated 03-02-07 and last revised on 06/08/07, prepared by PGT, signed and sealed by Robert L. Clark, P.E. (transferred from file # **07-0309.09**)
3. Glazing complies with ASTM E-1300-02 &-04

D. QUALITY ASSURANCE

1. Miami Dade Department of Permitting, Environment, and Regulatory Affairs (PERA).

E. MATERIAL CERTIFICATIONS

1. None

F. STATEMENTS

1. Statement letter of conformance and letter of no financial interest, prepared by PGT, dated 05/14/12, signed and sealed by Lyn Miller, P.E.
2. Statement letter issued by PGT, dated 05/14/12, "Renewal with no change "signed and sealed by Lyn Miller, P.E.
3. Statement letter dated OCT 11, 2011, compliance to FBC 2007 & FBC 2010 and "No financial interest", prepared by PGT, signed & sealed by Lynn Miller, P.E. (submitted under file # **11-1013.21**).
4. Statement letter of conformance and no financial interest, dated 03-02-07, signed by Robert L. Clark, P.E. (transferred from file # **07-0309.09**)
5. Letter of lab compliance, part of the above test reports.

G. OTHER

1. This NOA **renews # 11-1013.21**, expiring August 02, 2012.
2. Test proposal dated Jan. 17, 2007 approved by BCCO.

Ishaq I. Chanda
Ishaq I. Chanda, P.E.
Product Control Examiner
NOA No 12-0516.03
Expiration Date: August 02, 2017
Approval Date: August 02, 2012

NOTES: OUTSWING NON-IMPACT FRENCH DOOR(S) AND SIDE LITE(S)

- 1. GLAZING OPTIONS:
 A. 5/8" I.G. GLASS CONSISTING OF (2) LITES OF 3/16" TEMPERED GLASS WITH AN AIR SPACE BETWEEN.
 B. 5/8" I.G. GLASS CONSISTING OF (2) LITES OF 3/16" TEMPERED GLASS WITH AN AIR SPACE BETWEEN.
 C. POSITIVE DESIGN LOADS BASED ON WATER TEST PRESSURE AND GLASS TABLES ASTM E 1300-02.
 D. ANCHORAGE: THE 38 1/3% STRESS INCREASE HAS NOT BEEN USED IN THE DESIGN OF THIS PRODUCT. FOR ANCHORAGE REQUIREMENTS SEE SHEETS 6-11. MATERIALS, INCLUDING BUT NOT LIMITED TO STEEL SCREWS, THAT COME INTO CONTACT WITH OTHER DISSIMILAR MATERIALS SHALL MEET THE REQUIREMENTS OF THE FBC, CURRENT EDITION.
- 5. SHUTTERS ARE REQUIRED WHERE IMPACT RESISTANCE REQUIRED. SHUTTERS MUST BE MIMBADE COUNTY APPROVED FOR INSTALLATION IN MIMBADE COUNTY.
- 6. SEALANTS: INSTALLATION SCREWS, FRAME AND PANEL CORNERS SEALED WITH CLEAR COLORED SEALANT.
- 7. REFERENCES: TEST REPORT FTI-4964, ELCO TEXTRON NOA: 04-0721.01, 03-0226.06.
- 8. THIS PRODUCT HAS BEEN DESIGNED & TESTED TO COMPLY WITH THE REQUIREMENTS OF THE FLORIDA BUILDING CODE, INCLUDING THE HIGH VELOCITY HURRICANE ZONE (HVHZ).
- 9. CONFIGURATIONS WHICH CONTAIN A SIDE LITE TO DOOR CONNECTION:
 A. THE LOWER DESIGN PRESSURE FROM TABLE 1 OR 2 PREVAILS.
 B. FULL LENGTH REINFORCEMENT (ITEM 22 SHOWN IN SECTION E-E, SHEET 5), IS REQUIRED ONLY AT ALL DOOR TO SIDE LITE CONNECTIONS FROM TABLE 1 AND 2. ONLY REFER TO TABLES 1A AND 2A, SHEET 2 FOR DOOR TO SIDE LITE CONNECTIONS WHICH DO NOT REQUIRE ITEM 22 REINFORCEMENT.
 10. SINGLE DOORS 83 5/8" WIDE OR OVER AND THE OPERABLE PANEL OF DOUBLE DOORS 64 1/8" WIDE OR OVER COMPLY WITH THE EGRESS REQUIREMENTS OF THE FBC. NARROWER DOORS MAY BE USED WHERE EGRESS IS NOT REQUIRED BY CODE.

TABLE 1. DESIGN PRESSURES: OUTSWING DOORS
 (SEE NOTE 9A AND 9B ABOVE FOR OX, XO, XX, OXX, OXO & OXXO)

CONFIG.	DOOR	WDTH	8" - 79 3/4"	7" - 83 3/4"	6" - 85 3/4"	8" - 95 3/4"
X	2'	26 1/2"	+75.0	-112.1	+75.0	-105.8
X	2'	27 1/2"	+75.0	-105.0	+75.0	-98.0
X	2'	29 1/2"	+75.0	-98.9	+75.0	-93.2
X	2'	31 1/2"	+75.0	-93.7	+75.0	-88.3
X	2'	33 1/2"	+75.0	-82.3	+75.0	-79.3
X	3'	36 1/2"	+72.9	-72.9	+72.9	-72.9
X	3'	37 1/2"	+65.0	-65.0	+65.0	-65.0
XX	4'	47 3/4"	+75.0	-112.1	+75.0	-105.8
XX	6'	61 3/4"	+75.0	-105.0	+75.0	-98.0
XX	6'	65 3/4"	+75.0	-98.9	+75.0	-93.2
XX	6'	69 3/4"	+75.0	-93.7	+75.0	-88.3
XX	6'	71 3/4"	+65.0	-65.0	+65.0	-65.0

TABLE 2. DESIGN PRESSURES: SIDE LITE (SEE NOTE 9A & 9B ABOVE)

SIDE LITE	WDTH	6" - 79 3/4"	7" - 83 3/4"	8" - 85 3/4"	8" - 95 3/4"
10 3/4"	+75.0	-160.0	+75.0	-150.0	+75.0
12 3/4"	+75.0	-160.0	+75.0	-150.0	+75.0
18"	+75.0	-138.6	+75.0	-131.0	+75.0
21 3/4"	+75.0	-123.4	+75.0	-116.8	+75.0
27 3/4"	+75.0	-101.1	+75.0	-95.3	+75.0
36 1/8"	+67.3	-67.3	+67.3	-67.3	+67.3
38 3/4"	+65.0	-65.0	+65.0	-65.0	+65.0

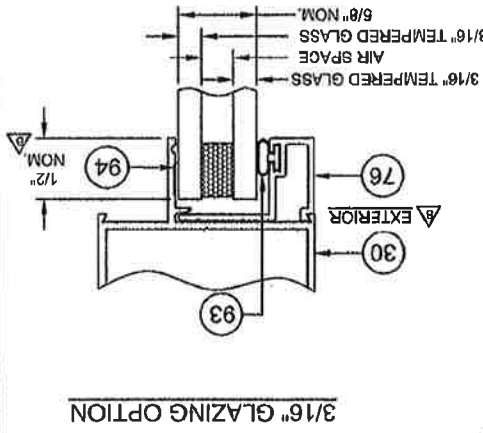
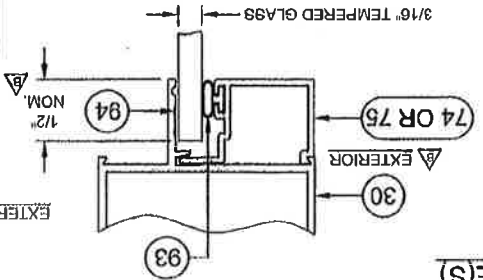


TABLE 2. DESIGN PRESSURES: SIDE LITE (SEE NOTE 9A & 9B ABOVE)

SIDE LITE	WDTH	6" - 79 3/4"	7" - 83 3/4"	8" - 85 3/4"	8" - 95 3/4"
10 3/4"	+75.0	-160.0	+75.0	-150.0	+75.0
12 3/4"	+75.0	-160.0	+75.0	-150.0	+75.0
18"	+75.0	-138.6	+75.0	-131.0	+75.0
21 3/4"	+75.0	-123.4	+75.0	-116.8	+75.0
27 3/4"	+75.0	-101.1	+75.0	-95.3	+75.0
36 1/8"	+67.3	-67.3	+67.3	-67.3	+67.3
38 3/4"	+65.0	-65.0	+65.0	-65.0	+65.0

NOTES, DESIGN PRESSURES & GLAZING DETAILS

RGT Ready Glazing Technology

4070 TECHNOLOGY DRIVE
 NOKOMIS, FL 34278
 P.O. BOX 1638
 NOKOMIS, FL 34274

PROJECT: ALUM. FRENCH DOOR & SIDE LITES, NON-IMPACT
 DRAWING NO.: 11008-2
 SCALE: 1/4" = 1'-0"

NOA DRAWING MAP

TOPIC SHEET

- 1. GENERAL NOTES
- 2. CONFIGURATIONS
- 3. ELEVATIONS
- 4. VERT. SECTIONS
- 5. HORIZ. SECTIONS
- 6. PARTS LIST
- 7. EXTRUSIONS
- 8. ANCHORAGE

PROBUC REVISED: 11-10-21
 Approved By: Anthony Linn Miller
 Approved Date: 08/02/2017

PROBUC REVISED: 08/02/2017
 Approved By: Anthony Linn Miller
 Approved Date: 08/02/2017

PROBUC REVISED: 08/02/2017
 Approved By: Anthony Linn Miller
 Approved Date: 08/02/2017

ANTHONY LINN MILLER
 PROFESSIONAL ENGINEER
 STATE OF FLORIDA
 NO. 58705

A. LYNN MILLER, P.E.
 FL P.E.# 88706

Drawn By: J.J. 1/16/07	Checked By: J.J. 2/28/07
Revised By: J.J. 4/27/07	Revised By: J.J. 2/28/07
Revised By: J.J. 8/23/07	Revised By: J.J. 2/28/07
Revised By: J.J. 10/10/11	Revised By: J.J. 2/28/07

NO CHANGES THIS SHEET

NO CHANGES THIS SHEET

NEW SHEET: ADD TABLES 1A AND 2A FOR 30 P.S.F. TIGHT DOOR WITHOUT REINFORCEMENT IN SIDE LITE TO DOOR CONNECTION.

1070 TECHNOLOGY DRIVE
NOKOMIS, FL 34478
P.O. BOX 1528
NOKOMIS, FL 34474



Vibby Ducter

ALUM. FRENCH DOOR & SIDE LITES, NON-IMPACT

11005-2

A. LYNN MILLER, P.E.
FL P.E.# 58705



PRODUCT MARKING
as complying with the Florida
Building Code
Acceptance No. 12-0516-03
Expiration Date 08/02/17
By: [Signature]

PRODUCT MARKING
as complying with the Florida
Building Code
Acceptance No. 11-1015-21
Expiration Date 03/27/2012
By: [Signature]



NOTES:
1. CONFIGURATIONS WHICH CONTAIN A SIDE LITE TO DOOR CONNECTION:
A. THE LOWER DESIGN PRESSURE FROM TABLE 1A, OR 2A, PREVAILS.
B. DOOR AND SIDE LITE COMBINATIONS FROM TABLES 1A, AND 2A, DO NOT REQUIRE REINFORCEMENT ITEM 22.
2. POSITIVE DESIGN PRESSURE IS LIMITED TO 60 P.S.F. (WATER RESISTANCE 90 P.S.F.) FOR DOORS AND SIDE LITES IN TABLES 1A AND 2A.
3. DESIGN PRESSURES UNDER 40 P.S.F. ARE NOT APPLICABLE IN MIAMI-DADE COUNTY.

CONFIG.	DOOR	DOOR HEIGHT	8" - 95 3/4"	7" - 83 3/4"	87 3/4"	8" - 95 3/4"				
X	2" 26 1/2"	+60.0	-60.3	+57.0	+57.0	+64.0	-54.0	+51.3	-48.8	-48.8
X	27 1/2"	+56.5	-56.5	+53.3	+53.3	+50.5	-50.5	+47.9	-47.9	-45.6
X	29 1/2"	+53.3	-53.3	+50.2	+50.2	+47.5	-47.5	+45.0	-45.0	-42.8
X	2" 31 1/2"	+50.5	-50.5	+47.5	+47.5	+44.9	-44.9	+42.6	-42.6	-40.5
X	2" 33 1/2"	+44.3	-44.3	+44.3	+44.3	+42.7	-42.7	+40.4	-40.4	-38.4
X	36 1/2"	+39.3	-39.3	+39.3	+39.3	+38.6	-38.6	+36.0	-36.0	-36.6
X	3" 37 1/2"	+35.0	-35.0	+35.0	+35.0	+35.0	-35.0	+35.0	-35.0	-35.0
XX	4" 47 3/4"	+60.0	-60.3	+57.0	+57.0	+54.0	-54.0	+51.3	-48.8	-48.8
XX	61 3/4"	+56.5	-56.5	+53.3	+53.3	+50.5	-50.5	+47.9	-47.9	-45.6
XX	66 3/4"	+53.3	-53.3	+50.2	+50.2	+47.5	-47.5	+45.0	-45.0	-42.8
XX	6" 69 3/4"	+50.5	-50.5	+47.5	+47.5	+44.9	-44.9	+42.6	-42.6	-40.5
XX	8" 63 3/4"	+44.3	-44.3	+44.3	+44.3	+42.7	-42.7	+40.4	-40.4	-38.4
XX	87 3/4"	+39.3	-39.3	+39.3	+39.3	+38.6	-38.6	+36.0	-36.0	-36.6
XX	8" 71 3/4"	+35.0	-35.0	+35.0	+35.0	+35.0	-35.0	+35.0	-35.0	-35.0

TABLE 2A, DESIGN PRESSURES: SIDE LITE	WIDTH	6" - 79 3/4"	7" - 83 3/4"	87 3/4"	91 3/4"	8" - 95 3/4"			
SIDE LITE	10 3/4"	+60.0	-120.0	+60.0	-118.1	+60.0	-107.2	+60.0	-102.4
	12 3/4"	+60.0	-108.4	+60.0	-100.9	+60.0	-95.9	+60.0	-87.3
	18"	+60.0	-74.6	+60.0	-70.5	+60.0	-66.9	+60.0	-60.7
	21 3/4"	+60.0	-66.4	+60.0	-62.8	+60.0	-59.5	+60.0	-53.9
	27 3/4"	+54.4	-54.4	+51.3	-51.3	+48.5	-48.5	+46.1	-43.8
	36 1/8"	+36.2	-36.2	+36.2	-36.2	+36.2	-36.2	+36.2	-35.5
	36 3/4"	+35.0	-35.0	+35.0	-35.0	+35.0	-35.0	+35.0	-35.0

Drawn By: J.T. 2/28/07	Checked By: J.T. 2/28/07	Project: 11005-2	Sheet: 3 of 11	Division: PD101	Contract: Vallyu Better	Company: RGT	Address: 1070 TECHNOLOGY DRIVE NOKOMIS, FL 34478	Address: P.O. BOX 1828 NOKOMIS, FL 34474	Address: 11005-2 A. LYNN MILLER, P.E. FL P.E.# 88706
------------------------	--------------------------	------------------	----------------	-----------------	-------------------------	--------------	---	---	--

1. FOR ANCHORAGE DETAILS SEE SHEETS 8 THROUGH 11.
 2. FOR HORIZONTAL AND VERTICAL SECTIONS SEE SHEETS 4 AND 5.
 3. SIDE LITES OVERLAP 'X' AND 'XX' DOORS BY 3/4" WHEN ASSEMBLED TO MAKE 'OXO' AND 'OXXO' CONFIGURATIONS.
 4. SEE TABLES 1, 1A, 2, AND 2A ON SHEETS 1 AND 2 FOR APPLICABILITY OF REINFORCEMENT FOR DOOR AND SIDE LITE CONFIGURATIONS.
 5. CLEAR OPENING FOR 'X' AND 'XX' DOORS AS FOLLOWS: ('X' DOORS = WIDTH - 5.646) ('XX' DOOR = DOOR WIDTH/2 - 4.079)
 6. SIDE LITE DLO WIDTH = SIDE LITE WIDTH - 3 1/4" 9M/SIDE LITE HEIGHT = SIDE LITE HEIGHT - 11"

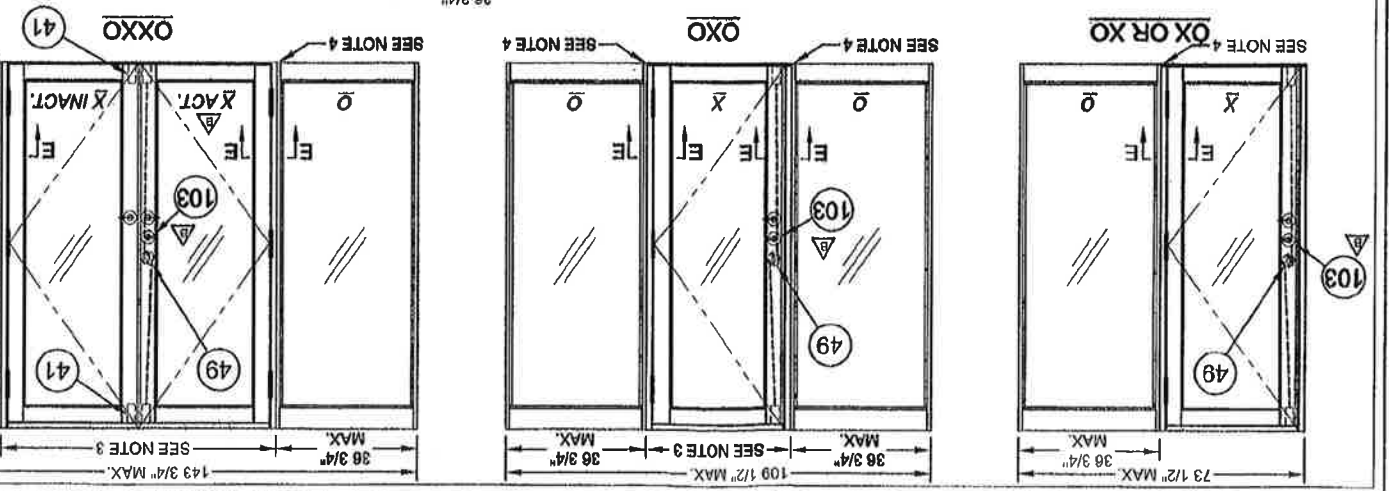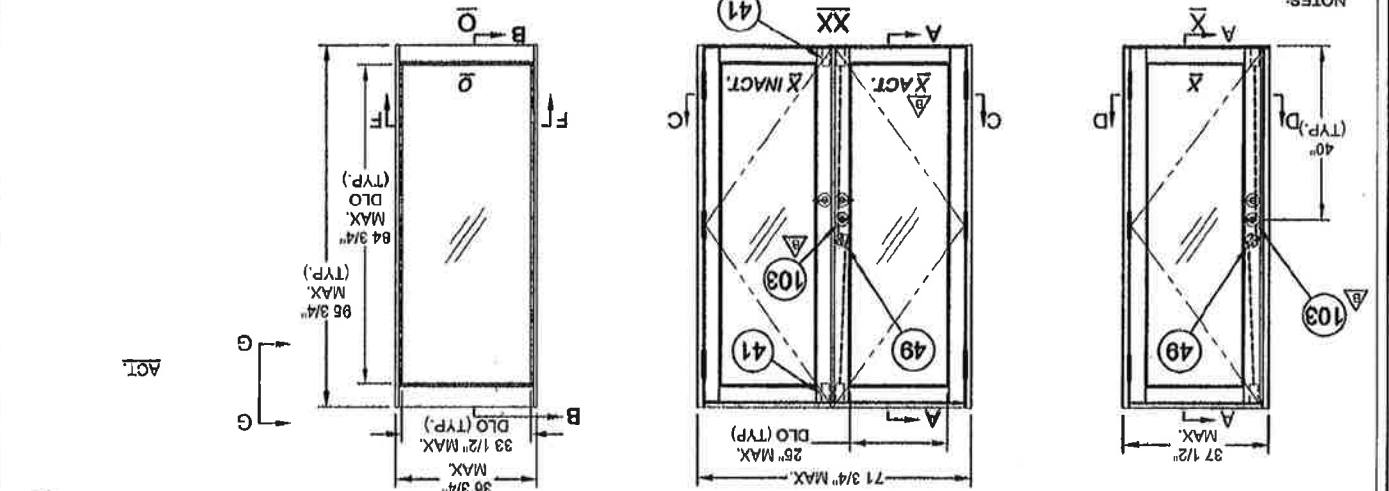

PRODUCT REVIEWED
 as complying with the Florida
 Building Code
 Acceptance No. 12-016-03
 By: [Signature]
 National Glass Product Council

PRODUCT REVIEWED
 as complying with the Florida
 Building Code
 Acceptance No. 11-103-21
 By: [Signature]
 National Glass Product Council




Revised By: Date: J.T. 10/10/11	Checked By: Date: J.T. 2/29/07
Rev'd 0: NO CHANGES THIS SHEET	Rev'd 1: NO CHANGES THIS SHEET
Rev'd 2: NO CHANGES THIS SHEET	Rev'd 3: NO CHANGES THIS SHEET
Rev'd 4: CORRECT ITEM AS VENDORSHIP & UPDATE ITEM 80 TO DOUBLE HOLLOW AND SET HEIGHT DIM.	Rev'd 5: CORRECT ITEM 46 VENDORSHIP & UPDATE ITEM 80 TO DOUBLE HOLLOW.
Rev'd 6: A	Rev'd 7: A
Rev'd 8: B	Rev'd 9: B
Rev'd 9: B	Rev'd 10: B
Rev'd 10: B	Rev'd 11: B
Rev'd 99: B	Rev'd 100: B

1070 TECHNOLOGY DRIVE
NOKOMIS, FL 34476
P.O. BOX 1629
NOKOMIS, FL 34474



Visby Bostler

Project: 11005-2	Sheet: 4 of 11	Date: 1/2	Scale: 1/2	Revision: FD101
ALUM. FRENCH DOOR & SIDE LITES, NON-IMPACT				
EXAMPLE ELEVATIONS				

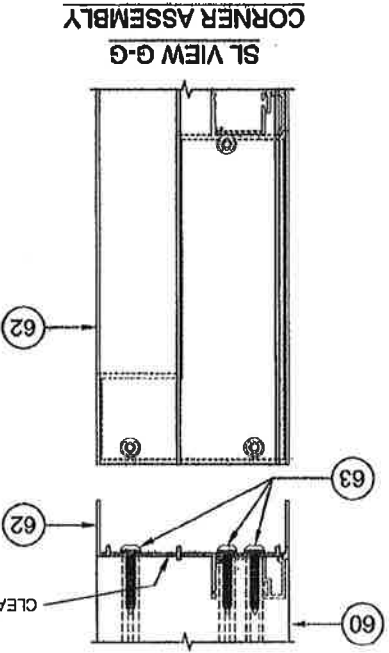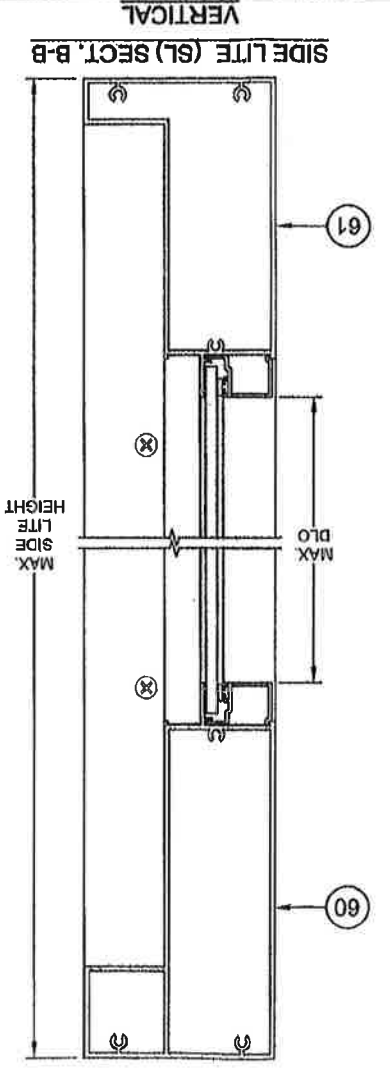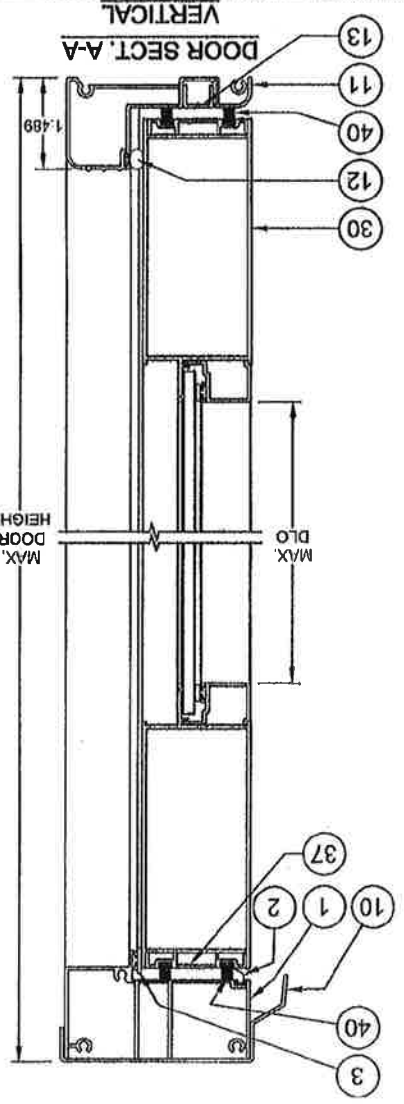

EXTERIOR ← → INTERIOR



PRODUCT REVIEWED
As complying with the Florida
Building Code
Acceptance No. 2-0516-03
Expiration Date: 8/2/21
By: [Signature]
1/19/15

PRODUCT REVIEWED
As complying with the Florida
Building Code
Acceptance No. 11-1013-21
Expiration Date: AUG 2, 2012
By: [Signature]
1/15/12

A. LYNN MILLER, P.E.
FL P.E.# 58705

Revised By:	J.J.	Date:	1/15/07
Revised By:	J.J.	Date:	4/27/07
Revised By:	J.J.	Date:	6/25/07
Revised By:	J.J.	Date:	2/28/07

NO CHANGES THIS SHEET

NO CHANGES THIS SHEET

CORRECT ITEMS 62 AND ADD ITEMS 4, 8 AND 10 (LOOK OVERMATION)

1070 TECHNOLOGY DRIVE
NOKOMIS, FL 34274


P.O. BOX 1929
NOKOMIS, FL 34274

VertiBy Better
RGT


VERTICAL SECTIONS
ALUM. FRENCH DOOR & SIDE LITES, NON-IMPACT
11005-2

FD101
Scale: 1/2
Sheet: 5 of 11
Drawing No. 11005-2


HORIZ. SLIDOR SECT. E-E

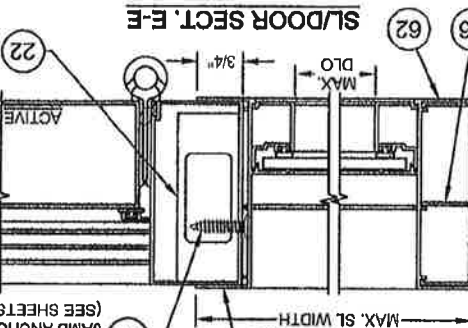


HORIZ. SL SECT. F-F

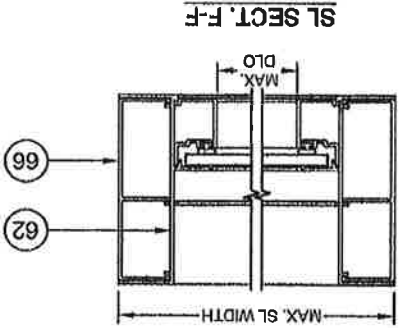

'X' SECT. D-D

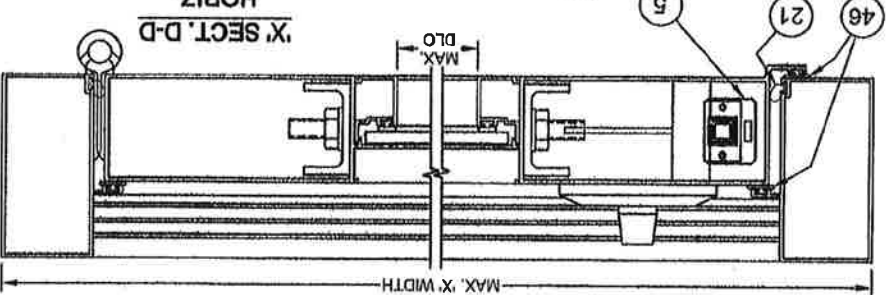


'XX' SECT. C-C

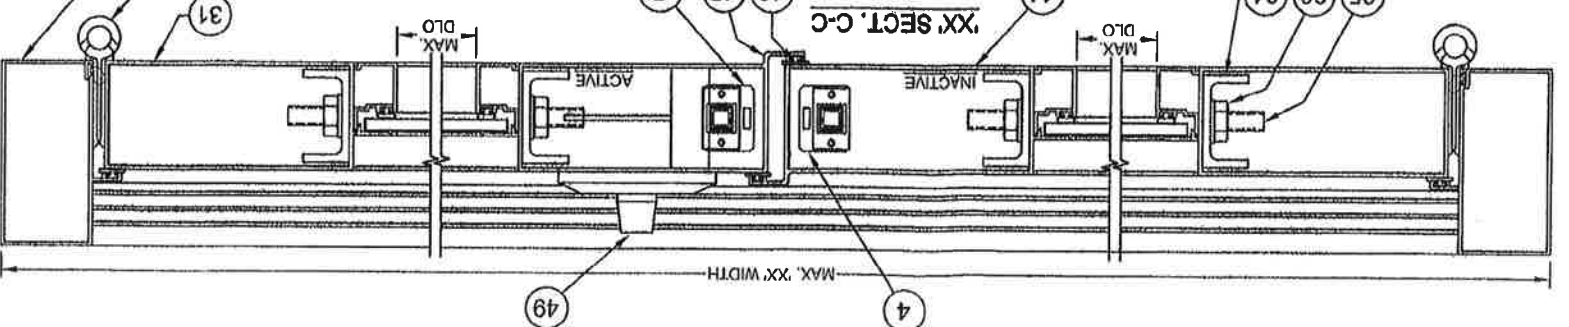

NOTE:
FULL LENGTH REINFORCEMENT
APPLICABLE TO DOOR AND SIDE
LITE COMBINATIONS FROM TABLES
1 AND 2, SHEET 1; ITEM 22 IS NOT
REQUIRED WITH COMBINATIONS
FROM TABLES 1A AND 2A, SHEET 2.

SPACING, SAME AS
JAMB ANCHOR SPACING
(SEE SHEETS 8, 9 AND 10)

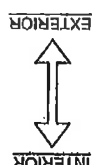


PRODUCT REVIEWED
as complying with the Florida
Building Code
Acceptance No. 12-516.03
Expiration Date: 02/22/17
By: [Signature]

PRODUCT REVIEWED
as complying with the Florida
Building Code
Acceptance No. 11-1013.21
Expiration Date: 01/20/12
By: [Signature]

FL P.E.# 69705
A. LYNN MILLER, P.E.

ITEM DWG #	DESCRIPTION	ITEM DWG #	DESCRIPTION
1	943B 00411	80	820D SIDELITE HEADER
2	1070 00300	81	821D SIDELITE SILL
3	7070 0707K	82	816B SIDELITE JAMB
4	955 7955X	83	81PQA #8 X 1.000 QUAD PN. SMS
5	956 7956A	84	888 7988
6	958 7958X	85	889 7989
7	8 7958A	86	824A 01641M
8	956 7956A	87	824A 01641M
9	956 7956A	88	824A 01641M
10	952A 853016	89	824A 01641M
11	11000 011000M	90	824A 01641M
12	1670 071870	91	824A 01641M
13	11004A 011004AM	92	824A 01641M
14	11001A 411001A	93	824A 01641M
15	11002A 411002A	94	824A 01641M
16	11003A 411003A	95	824A 01641M
17	11003A 411003A	96	824A 01641M
18	11003A 411003A	97	824A 01641M
19	11003A 411003A	98	824A 01641M
20	9160 80380	99	824A 01641M
21	1010 00300	100	824A 01641M
22	0608M 06608M	101	824A 01641M
23	1140 78X112PSATS	102	824A 01641M
24	1048 71048	103	824A 01641M
25	830 41721N	104	824A 01641M
26	830 41721N	105	824A 01641M
27	7070 0707K	106	824A 01641M
28	1118 710X4PFA	107	824A 01641M
29	1118 710X4PFA	108	824A 01641M
30	810D 0810	109	824A 01641M
31	917E 0811	110	824A 01641M
32	017 7FRMO	111	824A 01641M
33	1178 71058FP W.B	112	824A 01641M
34	913A 00378M	113	824A 01641M
35	1130 01TRODA	114	824A 01641M
36	990 7980NUTA	115	824A 01641M
37	914A 00378M	116	824A 01641M
38	990 7980NUTA	117	824A 01641M
39	987 70897	118	824A 01641M
40	1023 07824G	119	824A 01641M
41	928 41720	120	824A 01641M
42	1146 76X12PFAW	121	824A 01641M
43	1212 7P300G	122	824A 01641M
44	983B 0883	123	824A 01641M
45	984B 0884	124	824A 01641M
46	984B 0884	125	824A 01641M
47	929 74UBLOK	126	824A 01641M
48	1139 7834F	127	824A 01641M
49	982 702PAY	128	824A 01641M
50	08180FS	129	824A 01641M
51	930 41721	130	824A 01641M
52	931 7FRSPX	131	824A 01641M
53	1118 710X4PFA	132	824A 01641M
54	957 70857X	133	824A 01641M
55	1118 710X4PFA	134	824A 01641M

ITEM DWG #	DESCRIPTION	ITEM DWG #	DESCRIPTION
80	820D SIDELITE HEADER	103	OFF-THE SHELF DEAD BOLT LOCK
81	821D SIDELITE SILL	104	11008A 411008A ACETAL SPACER .286 (INHOUSE INJECTION MOULDED)
82	816B SIDELITE JAMB	105	GLASS, 6/8" LG., 3/16" TEMPERED, AIR SPACE, 3/16" TEMPERED
83	81PQA #8 X 1.000 QUAD PN. SMS	106	GLASS, 3/16" TEMPERED
84	888 7988	107	GLAZING SILICONE, DOW 889, 883 OR EQUIVALENT
85	889 7989	108	BULB, THICK (USED IN ALL EXTRUDED BEAD)
86	824A 01641M	109	BEAD, SIDE LITE INTERIOR
87	824A 01641M	110	BEAD, 5/8" LG
88	824A 01641M	111	BEAD, 3/16" (FOR GRILL KM)
89	824A 01641M	112	BEAD, 3/16"
90	824A 01641M	113	SETTING BLOCK, 1/16" X 1/2" X 1" W/PSA
91	821D 0821D	114	SETTING BLOCK, 3/32" X 1/4" X 1" W/PSA
92	816B 00381	115	#12 SHEET METAL SCREW
93	81PQA 781PQA	116	SIDELITE JAMB ADAPTER
94	888 7988	117	SIL GASKETS (STOCKING #70999)
95	889 7989	118	HEAD GASKETS (STOCKING #70999)
96	824A 01641M	119	SIDELITE JAMB ADAPTER
97	824A 01641M	120	SIDELITE JAMB ADAPTER
98	824A 01641M	121	SIDELITE JAMB ADAPTER
150	824A 01641M	173	SIDELITE JAMB ADAPTER

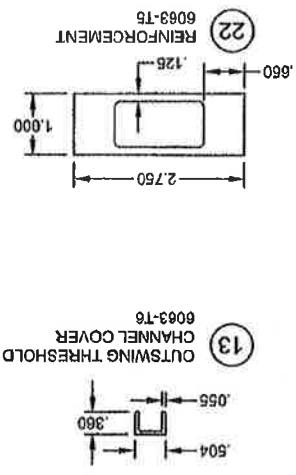

PARTS LIST & MISC. EXTRUSIONS

ALUM. FRENCH DOOR & SIDE LITES, NON-IMPACT

11005-2

PGT

1070 TECHNOLOGY DRIVE
NOKOMIS, FL 34216
P.O. BOX 1829
NOKOMIS, FL 34274

2/28/07















ANTHONY LYNN MILLER
Professional Engineer
No. 98705
State of Florida

FL P.E. # 98705
A. LYNN MILLER, P.E.

PRODUCT REVIEWED
As complying with the Florida Building Code
Acceptance No. 12-0516-03
By: *Shirley L. Lewis*
Expiration Date: 07/02/17

PRODUCT REVIEWED
As complying with the Florida Building Code
Acceptance No. 12-1013-21
By: *Shirley L. Lewis*
Expiration Date: 07/02/17

P.O. BOX 1820 NOKOMIS, FL 32874 1070 TECHNOLOGY DRIVE NOKOMIS, FL 32875	PRT Vally Butler	DRAWING NO. FD101 DATE 1/2 SHEET 7 P 11 11005-2	PROJECT ALUM. FRENCH DOOR & SIDE LITES, NON-IMPACT EXTRUSION PROFILES	REVISIONS 1/16/07 J.J. A UPDATED ITEM GO TO DOUBLE HOLLOW B ADD DOOR TO ITEM 20 C NO CHANGE THIS SHEET
--	----------------------------	--	---	---

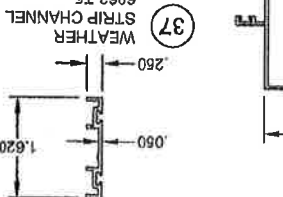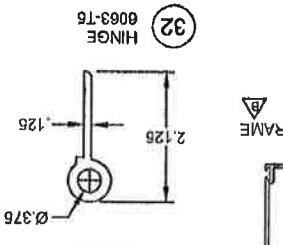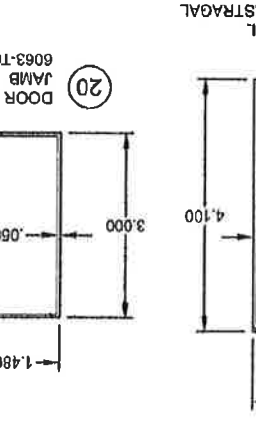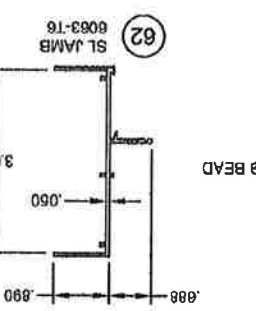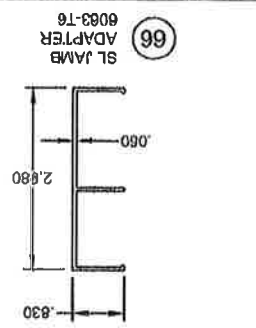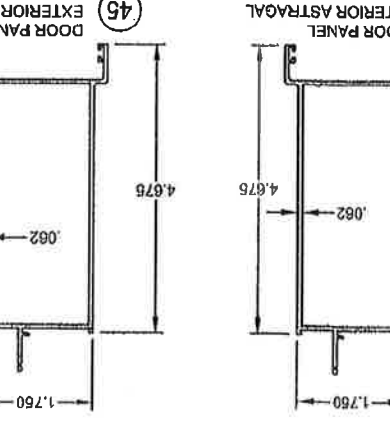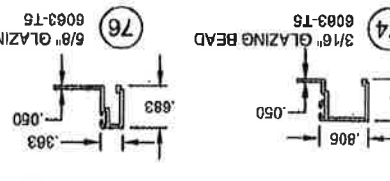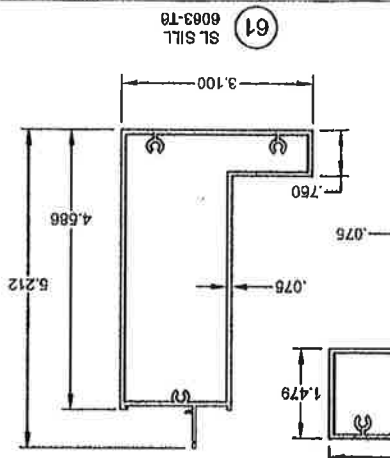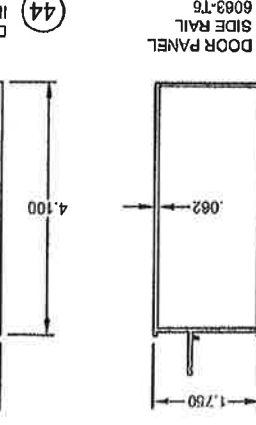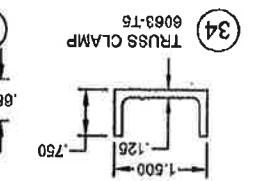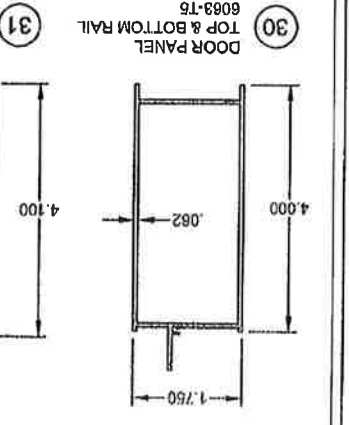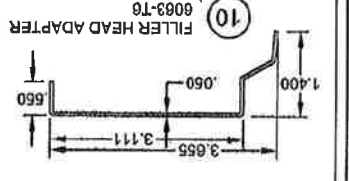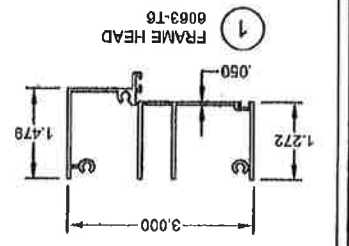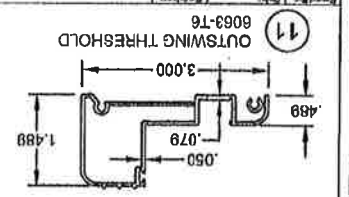

PRODUCT REVISED
 as compared with the Florida
 Building Code
 Acceptance No. 12-0516-03
 Expiration Date 08/07/17
 By *[Signature]*
 National Product Council

PRODUCT REVISED
 as compared with the Florida
 Building Code
 Acceptance No. 11-015-21
 Expiration Date 08/07/12
 By *[Signature]*
 National Product Council


FL P.E.# 68705
 A LYNN MILLER, P.E.
 PROFESSIONAL ENGINEER
 STATE OF FLORIDA
 LICENSE NO. 68705

Drawn By: J.J. 1/15/07	Checked By: J.J. 2/28/07	1070 TECHNOLOGY DRIVE NOKOMIS, FL 34478	FD101	NTS	8 of 11	11006-2
Drawn By: P.K. 4/27/07	Checked By: P.K. 5/2/07	P.O. BOX 1628 NOKOMIS, FL 34478	FD101	NTS	8 of 11	11006-2
Drawn By: P.K. 6/26/07	Checked By: P.K. 6/26/07	1070 TECHNOLOGY DRIVE NOKOMIS, FL 34478	FD101	NTS	8 of 11	11006-2
Drawn By: J.J. 10/11/11	Checked By: J.J. 10/11/11	NO CHANGE THIS SHEET	FD101	NTS	8 of 11	11006-2
Drawn By: J.J. 10/11/11	Checked By: J.J. 10/11/11	CHANGE XO OR XO' ANCHOR ZONE FROM C TO D	FD101	NTS	8 of 11	11006-2
Drawn By: P.K. 4/27/07	Checked By: P.K. 4/27/07	ADD EXAMPLE ANCHOR LAYOUT REF. TO NOTE 3	FD101	NTS	8 of 11	11006-2

ANCHORAGE CONFIGURATIONS



NOTES:
 1. APPROVED ANCHOR TYPES ARE: 1. 1/4" ELCO TAPCONS 2. 1/4" ELCO S54 CRETE-FLEX MASONRY ANCHORS 3. #12 SCREWS
 2. ANCHOR QUANTITIES ARE BASED ON SPACING AS FOLLOWS (3" MIN. O.C. FOR CONCRETE); SEE EXAMPLE XXXX ANCHOR LAYOUT ON SHEET 10.
 JAMBS (ALL): 13 1/4" MAX. FROM CORNERS AND 23 1/8" MAX. O.C.
 HEAD & SILL OF DOORS: 6" MAX. FROM CORNERS, 8" MAX. FROM ASTRAGAL CENTERS AND 20 7/8" MAX. O.C.
 HEAD & SILL OF SIDE LITES: 6" MAX. FROM CORNERS AND 24 3/4" MAX. O.C.
 3. TO DETERMINE ANCHOR QUANTITIES FIND THE CONFIGURATION ABOVE THEN REFER TO THE APPROPRIATE TABLES ON SHEETS 9 AND 10.

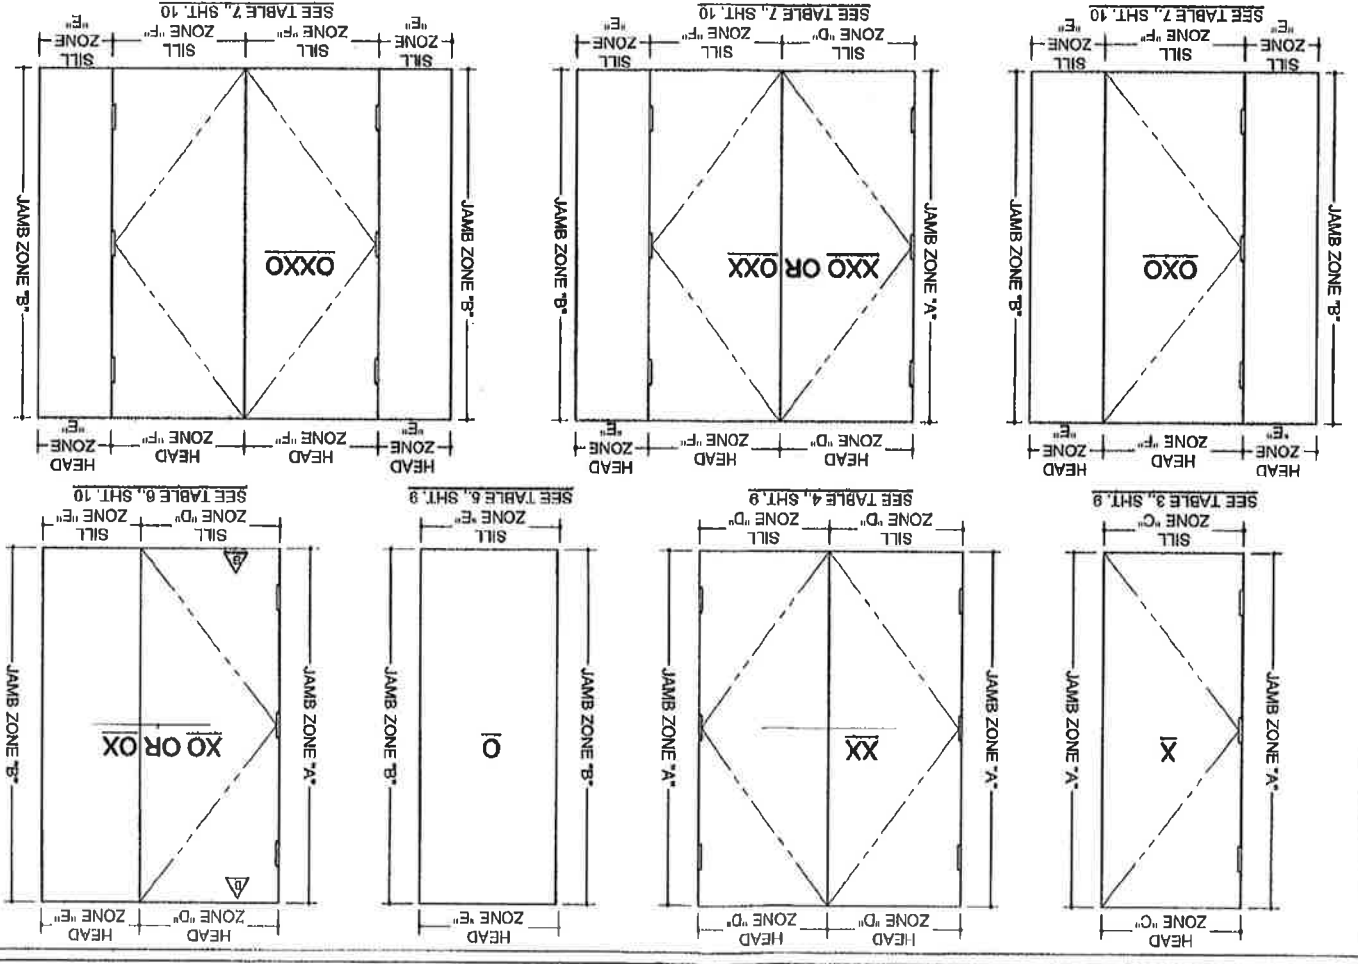


PRODUCT RENEWED
 as complying with the Florida
 Building Code 12-0516-03
 Appearance Date 09/22/17
 By: [Signature]

PRODUCT RENEWED
 as complying with the Florida
 Building Code 11-01-21
 Appearance Date 01/13/21
 By: [Signature]



PRODUCT RENEWED
as complying with the Florida
Building Code
Acceptance Date **12-05/16.03**
Expiration Date **08/27/17**
By **Wesley Miller**

PRODUCT RENEWED
as complying with the Florida
Building Code
Acceptance Date **11-16/15.21**
Expiration Date **08-24-2017**
By **Wesley Miller**

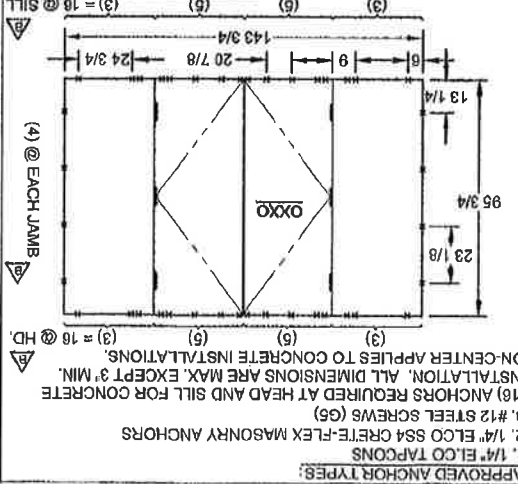

APPROVED ANCHOR TYPES:
1. 1/4" ELCO TAPCONS
2. 1/4" ELCO SS4 CRETE-FLEX MASONRY ANCHORS
3. #12 STEEL SCREWS (G6)
(16) ANCHORS REQUIRED AT HEAD AND SILL FOR CONCRETE INSTALLATION. ALL DIMENSIONS ARE MAX. EXCEPT 3" MIN. ON-CENTER APPLIES TO CONCRETE INSTALLATIONS. (3) = 18 @ HD.

EXAMPLE LARGEST OXXO ANCHORAGE

A. 3/8 3/4" x 96 3/4" SIDE LITE ANCHORS FROM TABLE 7 EA. JAMB "B" AND EA. HEAD AND SILL "E" ZONE PLUS:
B. 7 1/4" x 96 3/4" XX DOOR ANCHORS FROM TABLE 4, SHT. 9 AT EACH "F" ZONE.
SEE ENCLOSED VALUES, SHTS. 9 AND 10.
TOTALS (4) ANCHORS EA. JAMB AND 3+5+6+3 = (18) ANCHORS AT EACH HEAD AND SILL.

ANCHOR QTY. PER LOAD ZONE TABLES 6 & 7

ANCHOR TYPE	GLASS TYPES A AND B		ANCHOR TYPE	GLASS TYPES A AND B	
	2.3 WOOD	1.2 CONCRETE		2.3 WOOD	1.2 CONCRETE
TABLE 7. OXO, OXX & OXXO DOORS	DOOR WIDTHS		TABLE 6. XO & OX DOORS	DOOR WIDTHS	
	"X" - 26,600 TO 37,800	"XX" - 47,760 TO 71,760		"X" - 26,600 TO 37,800	"XX" - 47,760 TO 71,760
ANCHOR TYPE	GLASS TYPES A AND B	GLASS TYPES A AND B	ANCHOR TYPE	GLASS TYPES A AND B	GLASS TYPES A AND B
LOAD ZONES	O - JAMB "B"	O - JAMB "B"	LOAD ZONES	O - JAMB "B"	O - JAMB "B"
SIDE LITE WIDTH x HT.	X - JAMB "A"	X - JAMB "A"	SIDE LITE WIDTH x HT.	X - JAMB "A"	X - JAMB "A"
DOOR WIDTHS	X - JAMB "A"	X - JAMB "A"	DOOR WIDTHS	X - JAMB "A"	X - JAMB "A"
ANCHOR QTY.	X - JAMB "A"	X - JAMB "A"	ANCHOR QTY.	X - JAMB "A"	X - JAMB "A"

ANCHOR QTY.	ANCHOR TYPE	GLASS TYPES A AND B	ANCHOR QTY.	ANCHOR TYPE	GLASS TYPES A AND B
96,760	O - JAMB "B"	2.3 WOOD	96,760	O - JAMB "B"	2.3 WOOD
91,760	O - JAMB "B"	1.2 CONCRETE	91,760	O - JAMB "B"	1.2 CONCRETE
87,760	O - JAMB "B"	2.3 WOOD	87,760	O - JAMB "B"	2.3 WOOD
83,760	O - JAMB "B"	1.2 CONCRETE	83,760	O - JAMB "B"	1.2 CONCRETE
79,760	O - JAMB "B"	2.3 WOOD	79,760	O - JAMB "B"	2.3 WOOD
75,760	O - JAMB "B"	1.2 CONCRETE	75,760	O - JAMB "B"	1.2 CONCRETE
71,760	O - JAMB "B"	2.3 WOOD	71,760	O - JAMB "B"	2.3 WOOD
67,760	O - JAMB "B"	1.2 CONCRETE	67,760	O - JAMB "B"	1.2 CONCRETE
63,760	O - JAMB "B"	2.3 WOOD	63,760	O - JAMB "B"	2.3 WOOD
59,760	O - JAMB "B"	1.2 CONCRETE	59,760	O - JAMB "B"	1.2 CONCRETE
55,760	O - JAMB "B"	2.3 WOOD	55,760	O - JAMB "B"	2.3 WOOD
51,760	O - JAMB "B"	1.2 CONCRETE	51,760	O - JAMB "B"	1.2 CONCRETE
47,760	O - JAMB "B"	2.3 WOOD	47,760	O - JAMB "B"	2.3 WOOD
43,760	O - JAMB "B"	1.2 CONCRETE	43,760	O - JAMB "B"	1.2 CONCRETE
39,760	O - JAMB "B"	2.3 WOOD	39,760	O - JAMB "B"	2.3 WOOD
35,760	O - JAMB "B"	1.2 CONCRETE	35,760	O - JAMB "B"	1.2 CONCRETE
31,760	O - JAMB "B"	2.3 WOOD	31,760	O - JAMB "B"	2.3 WOOD
27,760	O - JAMB "B"	1.2 CONCRETE	27,760	O - JAMB "B"	1.2 CONCRETE
23,760	O - JAMB "B"	2.3 WOOD	23,760	O - JAMB "B"	2.3 WOOD
19,760	O - JAMB "B"	1.2 CONCRETE	19,760	O - JAMB "B"	1.2 CONCRETE
15,760	O - JAMB "B"	2.3 WOOD	15,760	O - JAMB "B"	2.3 WOOD
11,760	O - JAMB "B"	1.2 CONCRETE	11,760	O - JAMB "B"	1.2 CONCRETE
7,760	O - JAMB "B"	2.3 WOOD	7,760	O - JAMB "B"	2.3 WOOD
3,760	O - JAMB "B"	1.2 CONCRETE	3,760	O - JAMB "B"	1.2 CONCRETE

ANCHOR TYPE: GLASS TYPES A AND B
 DOOR WIDTHS: "X" - 26,600 TO 37,800; "XX" - 47,760 TO 71,760
 ANCHOR QTY. PER LOAD ZONE TABLES 6 & 7

ANCHOR TYPE	GLASS TYPES A AND B	ANCHOR TYPE	GLASS TYPES A AND B
TABLE 6. XO & OX DOORS	ANCHOR TYPE: GLASS TYPES A AND B	TABLE 7. OXO, OXX & OXXO DOORS	ANCHOR TYPE: GLASS TYPES A AND B
ANCHOR QTY.	ANCHOR TYPE	ANCHOR QTY.	ANCHOR TYPE
96,760	O - JAMB "B"	96,760	O - JAMB "B"
91,760	O - JAMB "B"	91,760	O - JAMB "B"
87,760	O - JAMB "B"	87,760	O - JAMB "B"
83,760	O - JAMB "B"	83,760	O - JAMB "B"
79,760	O - JAMB "B"	79,760	O - JAMB "B"
75,760	O - JAMB "B"	75,760	O - JAMB "B"
71,760	O - JAMB "B"	71,760	O - JAMB "B"
67,760	O - JAMB "B"	67,760	O - JAMB "B"
63,760	O - JAMB "B"	63,760	O - JAMB "B"
59,760	O - JAMB "B"	59,760	O - JAMB "B"
55,760	O - JAMB "B"	55,760	O - JAMB "B"
51,760	O - JAMB "B"	51,760	O - JAMB "B"
47,760	O - JAMB "B"	47,760	O - JAMB "B"
43,760	O - JAMB "B"	43,760	O - JAMB "B"
39,760	O - JAMB "B"	39,760	O - JAMB "B"
35,760	O - JAMB "B"	35,760	O - JAMB "B"
31,760	O - JAMB "B"	31,760	O - JAMB "B"
27,760	O - JAMB "B"	27,760	O - JAMB "B"
23,760	O - JAMB "B"	23,760	O - JAMB "B"
19,760	O - JAMB "B"	19,760	O - JAMB "B"
15,760	O - JAMB "B"	15,760	O - JAMB "B"
11,760	O - JAMB "B"	11,760	O - JAMB "B"
7,760	O - JAMB "B"	7,760	O - JAMB "B"
3,760	O - JAMB "B"	3,760	O - JAMB "B"

ANCHOR TYPE: GLASS TYPES A AND B
 DOOR WIDTHS: "X" - 26,600 TO 37,800; "XX" - 47,760 TO 71,760
 ANCHOR QTY. PER LOAD ZONE TABLES 6 & 7

NO CHANGE THIS SHEET
 CHANGE XX OR XX HEAD ZONE FROM "C" TO "D". ENHANCE EXAMPLE AND EACH ZONE OF TABLE 7 "E" UPDATES ALL TABLES DUE TO THIS REVISION.
 DATE: 2/28/07
 BY: J.J.
 CHECKED BY: J.J.
 DATE: 1/18/07
 F.K.
 1070 TECHNOLOGY DRIVE
 NOKOMIS, FL 34428
 P.O. BOX 1888
 NOKOMIS, FL 34428
 Valby Dwyer
 FD101
 NA
 10 of 11
 11005-2
 C
 A. LYNN MILLER, P.E.
 F.L.P.E. # 68705

Revised By: Date: 1/16/07	Checked By: J.L.	2/28/07
Revised By: Date: 1/16/07	Checked By: A	UPDATES SIDE LITE HEAD TO DOUBLE HOLLOW.
Revised By: Date: 05/20/07	Checked By: B	NO CHANGES THIS SHEET
Revised By: Date: 10/11/07	Checked By: C	NO CHANGES THIS SHEET













1970 TECHNOLOGY DRIVE
NOKOMIS, FL 34270
P.O. BOX 1029
NOKOMIS, FL 34274

RGT
Vahib Beber

Specification: F.D101	Date: 11/11/11	Drawn By: NTS	Sheet: 11 of 11	Project: 11005-2
ANCHORAGE DETAILS				
ALUM. FRENCH DOOR & SIDE LITES, NON-IMPACT				

NOTES:

1. FOR CONCRETE INSTALLATIONS IN MIAMI-DADE COUNTY, USE ONLY MIAMI-DADE COUNTY APPROVED ELCO 1/4" TAPCONS EMBEDDED 1 3/8" MIN. OR 1/4" SS4 CRETE-FLEX EMBEDDED 1 3/4" MIN. THE MINIMUM DISTANCE FROM CENTER OF ANCHOR TO CONCRETE EDGE IS 1 3/4". FOR WOOD INSTALLATIONS USE #12 SCREWS OR ELCO 1/4" SS4 CRETE-FLEX ANCHORS EMBEDDED 1 3/8" MIN.
2. WOOD BUCKS DEPICTED AS 1X ARE LESS THAN 1 1/2" THICK. 1X WOOD BUCKS ARE OPTIONAL IF UNIT IS INSTALLED DIRECTLY TO SOLID CONCRETE. WOOD BUCKS DEPICTED AS 2X ARE 1 1/2" THICK OR GREATER. INSTALLATION TO THE SUBSTRATE OF WOOD BUCKS TO BE ENGINEERED BY OTHERS OR AS APPROVED BY THE AUTHORITY HAVING JURISDICTION (A.H.J.).
3. IF SILL IS TIGHT TO SUBSTRATE, GROUT OR OTHER MATERIAL IS NOT REQUIRED. IF USED, NON-SHRINK, NON-METALLIC GROUT (3360 PSI MIN.), (DONE BY OTHERS) MUST FULLY SUPPORT THE ENTIRE LENGTH OF THE SILL THAT IS NOT TIGHT TO THE SUBSTRATE, AND TRANSFER SHEAR LOAD TO SUBSTRATE. IF SUBSTRATE IS WOOD, 30# FELT PAPER OR MASTIC IS REQUIRED BETWEEN THE GROUT AND WOOD SUBSTRATE, OR AS APPROVED BY THE AUTHORITY HAVING JURISDICTION.

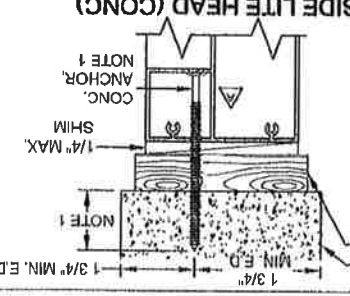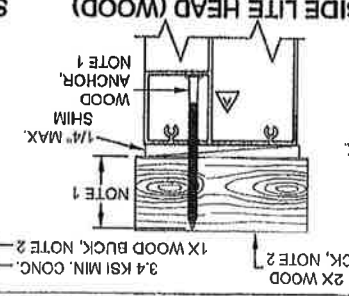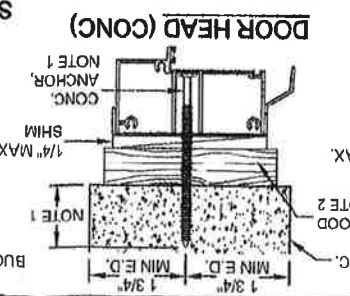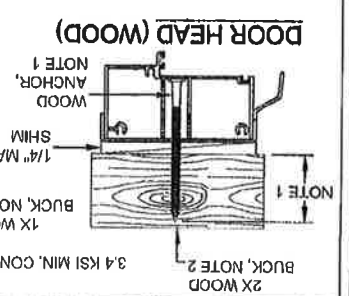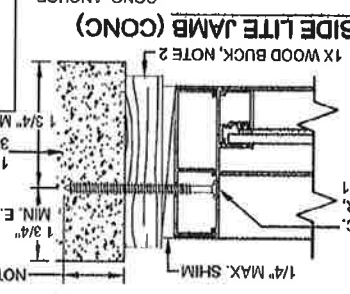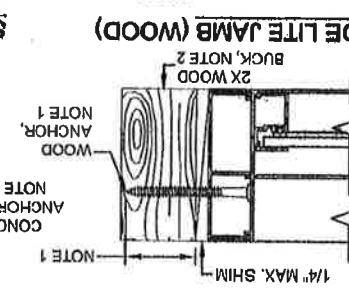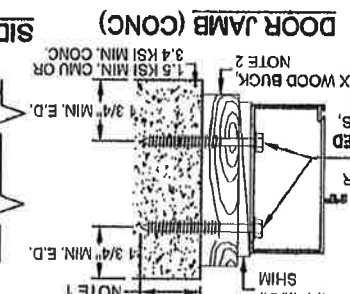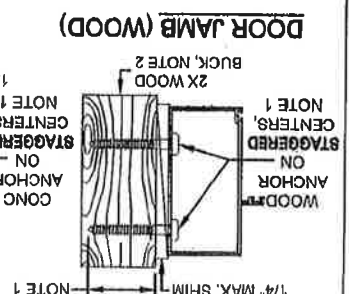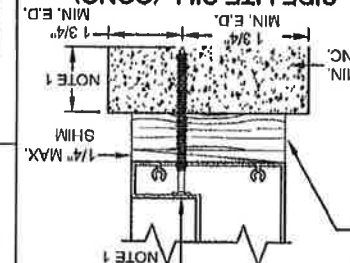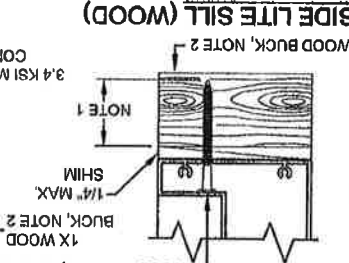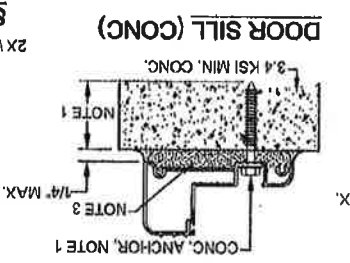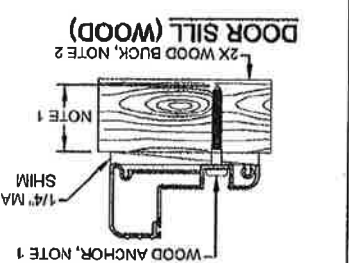

Product Revised
As Comparing with the Florida
Building Code
11-013, 21
Adoption on 11-013, 21
Expiration Date 11-013, 21
By: [Signature]
11/16/11

Product Revised
As Comparing with the Florida
Building Code
11-013, 21
Adoption on 11-013, 21
Expiration Date 11-013, 21
By: [Signature]
11/16/11

Product Revised
As Comparing with the Florida
Building Code
11-013, 21
Adoption on 11-013, 21
Expiration Date 11-013, 21
By: [Signature]
11/16/11

7157 Conway Cir < 25-23-29-5884-15-130 >

Physical Street Address
 Stewart Pamela L
 7157 Conway Cir
 Mailing Address On File
 7157 Conway Cir
 Belle Isle, FL 32809-6801
 Property Use
 0101 - Single Family
 Municipality
 Belle Isle



Property Description
 NE1/4 ISLE M/55 LOT 13 & SE1/2 OF LOT 12 BLK O

Total Land Area 10,397 sqft (+/-) | 0.24 acres (+/-) GIS Calculated Notice

Land Use Code	Zoning	Land Units	Unit Price	Land Value	Class Unit Price	Class Value
0100 - Single Family	R-1-A	1 LOT(S)	\$50,000.00	\$50,000	\$0.00	\$50,000

Page 1 of 1 (1 total records)

Buildings

Important Information		Structure	
Model Code: 0101 - Single Family Residence	Actual Year Built: 1955	Gross Area: 2058 sqft	Living Area: 1728 sqft
Type Code: 0101 - Single Family	Beds: 3	Exterior Wall: Concrete Block Stucco	Interior Wall: Plastered
Building Value: \$63,052	Baths: 2.5		
Estimated New Cost: \$121,253	Floors: 1		

Page 1 of 1 (1 total records)

Extra Features

Description	Date Built	Units	XFOB Value
PL1 - Typical 0100 Pool	01/01/1990	1 Unit(s)	\$4,340
PT2 - Patio 2	01/01/1990	1 Unit(s)	\$2,000
CVAL - Aluminum Cover	01/01/1991	544 Square Feet	\$1,360

Page 1 of 1 (3 total records)

This Data Printed on 11/27/2013 and System Data Last Refreshed on 11/26/2013

Site Notice • About Us • Contact Us • OCPAFL Home • Property Search
 Orange County Property Appraiser • 200 S. Orange Avenue, Suite 1700 • Orlando, FL 32801
 Office Hours: 8:00 a.m. to 5:00 p.m. Monday - Friday • Phone: 407.836.5044
 Copyright © 2010 Orange County Property Appraiser. All rights reserved.



CERTIFICATE OF LIABILITY INSURANCE

DATE (MM/DD/YYYY)
07/22/2013

THIS CERTIFICATE IS ISSUED AS A MATTER OF INFORMATION ONLY AND CONFERS NO RIGHTS UPON THE CERTIFICATE HOLDER. THIS CERTIFICATE DOES NOT AFFIRMATIVELY OR NEGATIVELY AMEND, EXTEND OR ALTER THE COVERAGE AFFORDED BY THE POLICIES BELOW. THIS CERTIFICATE OF INSURANCE DOES NOT CONSTITUTE A CONTRACT BETWEEN THE ISSUING INSURER(S), AUTHORIZED REPRESENTATIVE OR PRODUCER, AND THE CERTIFICATE HOLDER.

IMPORTANT: If the certificate holder is an ADDITIONAL INSURED, the policy(ies) must be endorsed. If SUBROGATION IS WAIVED, subject to the terms and conditions of the policy, certain policies may require an endorsement. A statement on this certificate does not confer rights to the certificate holder in lieu of such endorsement(s).

PRODUCER MARSH USA, INC. TWO ALLIANCE CENTER 3560 LENOX ROAD, SUITE 2400 ATLANTA, GA 30326	CONTACT NAME: PHONE (A/C, No., Ext): FAX (A/C, No): E-MAIL ADDRESS:
100492-HomeD-GW-FL-13-14 MU	INSURER(S) AFFORDING COVERAGE INSURER A : Steadfast Insurance Company NAIC # 26387 INSURER B : Illinois National Insurance Company 23817 INSURER C : INSURER D : INSURER E : INSURER F :

COVERAGES CERTIFICATE NUMBER: ATL-003148883-03 REVISION NUMBER: 0

THIS IS TO CERTIFY THAT THE POLICIES OF INSURANCE LISTED BELOW HAVE BEEN ISSUED TO THE INSURED NAMED ABOVE FOR THE POLICY PERIOD INDICATED, NOTWITHSTANDING ANY REQUIREMENT, TERM OR CONDITION OF ANY CONTRACT OR OTHER DOCUMENT WITH RESPECT TO WHICH THIS CERTIFICATE MAY BE ISSUED OR MAY PERTAIN, THE INSURANCE AFFORDED BY THE POLICIES DESCRIBED HEREIN IS SUBJECT TO ALL THE TERMS, EXCLUSIONS AND CONDITIONS OF SUCH POLICIES. LIMITS SHOWN MAY HAVE BEEN REDUCED BY PAID CLAIMS.

INSR LTR	TYPE OF INSURANCE	ADDL SUBR INSR WVD	POLICY NUMBER	POLICY EFF (MM/DD/YYYY)	POLICY EXP (MM/DD/YYYY)	LIMITS
A	GENERAL LIABILITY X COMMERCIAL GENERAL LIABILITY CLAIMS-MADE <input checked="" type="checkbox"/> OCCUR		GLO4887714-03 "LIMITS OF POLICY XS" "OF SIR: \$1M PER OCC"	03/01/2013	03/01/2014	EACH OCCURRENCE \$ 9,000,000 DAMAGE TO RENTED PREMISES (Ea occurrence) \$ 1,000,000 MED EXP (Any one person) \$ EXCLUDED PERSONAL & ADV INJURY \$ 9,000,000 GENERAL AGGREGATE \$ 9,000,000 PRODUCTS - COMP/OP AGG \$ 9,000,000
	GEN'L AGGREGATE LIMIT APPLIES PER: X POLICY <input type="checkbox"/> PRO-JECT <input type="checkbox"/> LOC					COMBINED SINGLE LIMIT (Ea accident) \$ BODILY INJURY (Per person) \$ BODILY INJURY (Per accident) \$ PROPERTY DAMAGE (Per accident) \$ EACH OCCURRENCE \$ AGGREGATE \$
	AUTOMOBILE LIABILITY ANY AUTO ALL OWNED AUTOS HIRED AUTOS					SCHEDULED AUTOS NON-OWNED AUTOS
	UMBRELLA LIAB EXCESS LIAB					OCCUR CLAIMS-MADE DED. RETENTION \$
B	WORKERS COMPENSATION AND EMPLOYER'S LIABILITY ANY PROPRIETOR/PARTNER/EXECUTIVE OFFICER/MEMBER EXCLUDED? (Mandatory in NH) If yes, describe under DESCRIPTION OF OPERATIONS below		WC033575316 (FL)	03/01/2013	03/01/2014	X WC STATUS TOBY LIMITS OTHER \$ 1,000,000 E.L. EACH ACCIDENT \$ 1,000,000 E.L. DISEASE - EA EMPLOYEE \$ 1,000,000 E.L. DISEASE - POLICY LIMIT \$ 1,000,000

DESCRIPTION OF OPERATIONS / LOCATIONS / VEHICLES (Attach ACORD 101, Additional Remarks Schedule, if more space is required)

CERTIFICATE HOLDER

CITY OF BELLE ISLE
1600 NELA AVENUE
BELLE ISLE, FL 32809

CANCELLATION

SHOULD ANY OF THE ABOVE DESCRIBED POLICIES BE CANCELLED BEFORE THE EXPIRATION DATE THEREOF, NOTICE WILL BE DELIVERED IN ACCORDANCE WITH THE POLICY PROVISIONS.

AUTHORIZED REPRESENTATIVE
of Marsh USA Inc.

Manashi Mukherjee

Manashi Mukherjee

ACORD 25 (2010/05)

The ACORD name and logo are registered marks of ACORD

© 1988-2010 ACORD CORPORATION. All rights reserved.



AGENCY MARSH USA, INC.		NAMED INSURED THE HOME DEPOT, INC. HOME DEPOT U.S.A., INC. 2455 PAGES FERRY ROAD, NW BUILDING C-20 ATLANTA, GA 30339	
POLICY NUMBER		EFFECTIVE DATE:	
CARRIER	NAIC CODE		

ADDITIONAL REMARKS

THIS ADDITIONAL REMARKS FORM IS A SCHEDULE TO ACORD FORM,

FORM NUMBER: 25 FORM TITLE: Certificate of Liability Insurance

BOYSIE GANGA RAMDIAL - CRC046658
BOYD A LIPHAM - CCC1325818
EDWARD LYNN GUILLORY - CGC1507093
QUINN M ROBERTS- CCC058327
EDUARDO ESCUZA - CGC1518835
MICHAEL JAMES HOLEVA - CCC1325640
STEPHEN A. THOMPSON - CRC1330510
CHARLES F. HICKEY - CGC035844
JAMES P. DRAGO - CGC025763

WORKERS COMPENSATION IS COVERED IN THE STATE OF FLORIDA

***** HOME DEPOT INSUREDS****

Home Depot U.S.A., The Home Depot, Inc. Entity List

Home Depot USA, Inc. dba The Home Depot
THD At Home Services, Inc. dba The Home Depot At-Home Services
THD At-Home Services, Inc.
The Home Depot, Inc.
The Home Depot, Inc. Home Depot USA, Inc.
Your Other Warehouse, LLC
U.S. Home Systems, Inc.
U.S. Remodelers, Inc.



STATE OF FLORIDA

DEPARTMENT OF BUSINESS AND PROFESSIONAL REGULATION

CONSTRUCTION INDUSTRY LICENSING BOARD
1940 NORTH MONROE STREET
TALLAHASSEE

(850) 487-1395

FL 32399-0783

RAMDIAL, BOYSIE GANGA
THE HOME DEPOT AT-HOME SERVICES
2690 CUMBERLAND PKWY
SUITE 300
ATLANTA

GA 30339

Congratulations! With this license you become one of the nearly one million Floridians licensed by the Department of Business and Professional Regulation. Our professionals and businesses range from architects to yacht brokers, from boxers to barbecue restaurants, and they keep Florida's economy strong.

Every day we work to improve the way we do business in order to serve you better. For information about our services, please log onto www.myfloridalicense.com. There you can find more information about our divisions and the regulations that impact you, subscribe to department newsletters and learn more about the Department's initiatives.

Our mission at the Department is: License Efficiently, Regulate Fairly. We constantly strive to serve you better so that you can serve your customers. Thank you for doing business in Florida, and congratulations on your new license!



STATE OF FLORIDA

DEPARTMENT OF BUSINESS AND PROFESSIONAL REGULATION

AC# 6154636

CRC046858

06/06/12 118199306

CERTIFIED RESIDENTIAL CONTRACTOR
RAMDIAL, BOYSIE GANGA
THE HOME DEPOT AT-HOME SERVICES

IS CERTIFIED under the provisions of Ch.489 FS
Expiration date: AUG 31, 2014 L12060601558

DETACH HERE

THIS DOCUMENT HAS A COLORED BACKGROUND, MICROPRINTING, "LINEIMARK" PATENTED PAPER

AC# 6154636

STATE OF FLORIDA

DEPARTMENT OF BUSINESS AND PROFESSIONAL REGULATION
CONSTRUCTION INDUSTRY LICENSING BOARD

SEQ# L12060601558

DATE BATCH NUMBER LICENSE NBR

06/06/2012 118199306 CRC046858

The RESIDENTIAL CONTRACTOR

Named below IS CERTIFIED

Under the provisions of Chapter 489 FS.

Expiration date: AUG 31, 2014

RAMDIAL, BOYSIE GANGA
THE HOME DEPOT AT-HOME SERVICES
2690 CUMBERLAND PKWY
SUITE 300
ATLANTA

GA 30339

RICK SCOTT
GOVERNOR

KEN LAWSON
SECRETARY

2013-2014 HILLSBOROUGH COUNTY BUSINESS TAX RECEIPT

EXPIRES 9-30-2014 FOLIO NO.

STAMPS	FACILITIES OR MACHINES	ROOMS	SEATS	EMPLOYEES	RENEWAL	182589.0000
	0	0	0	1		

OCC. CODE	BUSINESS TYPE	H. WASTE SURCHARGE	TAX
090.022	RESIDENTIAL CONTRACTOR	40.00	18.00

2014

BUSINESS LOCATION 207 KELSEY LN K
TAMPA 33619

NAME MAILING ADDRESS RAMDIAL BOYSIE GANGA
DBA/THE HOME DEPOT AT-HOME SERVICES
2690 CUMBERLAND PKWY STE 300
ATLANTA GA 30339

BUSINESS TAX RECEIPT

HAS HEREBY PAID A PRIVILEGE TAX TO ENGAGE
IN BUSINESS, PROFESSION, OR OCCUPATION SPECIFIED HEREON

DOUG BELDEN, TAX COLLECTOR
678-635-5200
THIS BECOMES A TAX RECEIPT WHEN VALIDATED.

PAID - 28641 - 6
07/16/2013 *** 58.00