

2019-11-018



**CITY OF BELLE ISLE,  
FLORIDA**

Universal Engineering Sciences 3532 Maggie Blvd., Orlando, FL 32811  
Tel 407-581-8161 \* Fax 407-581-0313  
[COBIPermits@universalengineering.com](mailto:COBIPermits@universalengineering.com)

**Building Plans Review Comments**

**Location:** 5108 Mortier Avenue, City of Belle Isle. 20' x 15' Wood Shed  
**Plans Reviewer:** Benjamin Suriel  
**Date:** Nov. 08, 2019

1. Original plan set signed and sealed by a Registered Engineer/Architect, State of Florida, or provide FL approval for the modular building.

1.a\_If signed and sealed drawings will be used, please provide Florida Product approvals for the roof system, door(s), and windows, if any.

*For FL approved **modular building**, Product Approvals are not required.*

2. Sheet F-5 - please Indicate what foundation/ tie-downs will be used on this structure.

3. Sheet F-2 and F-3 - please indicate what tie-down schedule will be use on this structure.

4. Sheet F-4 – please indicate ground anchoring to be used on this structure.

no response from

- [Searches](#)
- [Sales Search](#)
- [Results](#)
- [Property Record Card](#)
- [My Favorites](#)

[Sign up for e-Notify...](#)

**5108 Mortier Ave** < 17-23-30-4378-01-040 >

Name(s)	Physical Street Address
Weston Michael W Jr	5108 Mortier Ave
Mailing Address On File	Postal City and Zipcode
5108 Mortier Ave	Orlando, FL 32812
Belle Isle, FL 32812-1053	Property Use
<a href="#">Incorrect Mailing Address?</a>	0103 - Single Fam Class III
	Municipality
	Belle Isle



**View 2019 Property Record Card**

- [Property Features](#)
- [Values, Exemptions and Taxes](#)
- [Sales Analysis](#)
- [Location Info](#)
- [Market Stats](#)
- [Update Information](#)

**2020 values will be available in August of 2020.**

**Property Description**

[View Plat](#)

LAKE CONWAY ESTATES SECTION ONE X/37 LOT 4 BLK A

**Total Land Area** 10,626 sqft (+/-) | 0.24 acres (+/-) [GIS Calculated](#) [Notice](#)

**Land**

Land Use Code	Zoning	Land Units	Unit Price	Land Value	Class Unit Price	Class Value
0100 - Single Family	R-1-AA	1 LOT(S)	working...	working...	working...	working...

Page 1 of 1 (1 total records)

**Buildings**

Important Information		Structure				
	<b>Model Code:</b>	01 - Single Fam Residence	<b>Actual Year Built:</b>	1959	<b>Gross Area:</b>	2673 sqft
	<b>Type Code:</b>	0103 - Single Fam Class III	<b>Beds:</b>	4	<b>Living Area:</b>	2067 sqft
	<b>Building Value:</b>	working...	<b>Baths:</b>	2.0	<b>Exterior Wall:</b>	Concrete/Cinder Block
	<b>Estimated New Cost:</b>	working...	<b>Floors:</b>	1	<b>Interior Wall:</b>	Drywall

Page 1 of 1 (1 total records)

**Extra Features**

Description	Date Built	Units	XFOB Value
FPL2 - Fireplace 2	01/01/1959	1 Unit(s)	working...
PL2 - Pool 2	01/01/1959	1 Unit(s)	working...
SCR2 - Scrn Enc 2	01/01/1990	1 Unit(s)	working...

Page 1 of 1 (3 total records)

This Data Printed on 11/07/2019 and System Data Last Refreshed on 11/06/2019



# UNIVERSAL ENGINEERING SCIENCES

Consultants In: Geotechnical Engineering • Environmental Sciences  
Geophysical Services • Materials Testing • Threshold Inspection  
Building Code Administration, Compliance Inspection & Plan Review

3532 Maggie Blvd, Orlando, FL 32811 - P: 407.423.0504 - F: 407.423.3106

Work Order No. 158512

## Inspection Report

Project Name: 5108 Mortier Avenue ~ COBI

Address: 5108 Mortier Avenue ~ COBI, Belle Isle, Orange County, FL

Client: City of Belle Isle

ProjectNo.: 0115.1900355.0000-0115-001

Scope of Inspection: REVIEW app for shed - make list of deficiencies

Inspection Type:

Date: 11/07/2019 Any any

Permit No: 2019-11-018

Lot No.:

Contact: Susan Manchester at 407

## Disposition of Inspection:

Comments:

I hereby affirm that to the best of my knowledge and belief, the above listed inspection was performed as indicated and the work was reviewed for compliance with the approved plans, and all pertinent sections of the Florida Building Code.

Inspector: Benjamin Suriel

## Susan Manchester

---

**From:** Susan Manchester  
**Sent:** Tuesday, November 12, 2019 7:49 AM  
**To:** Benjamin Suriel  
**Cc:** CobiPermits; Michael Weston; David Olivieri  
**Subject:** RE: 5108 Mortier Ave - Shed permit 2019-11-018 cannot be approved as submitted - By Owner Michael Weston

Hello Ben,

David was not able to contact Michael Weston yesterday. Would you please reach out to him today?

Mike Weston  
321-615-7858

Thank you,

*Susan Manchester*

Permit Administration for the City of Belle Isle  
Building Inspections and  
Code Compliance Department  
407-423-0504 X23309 or 407-581-8161 option permits  
E-mail: [smanchester@universalengineering.com](mailto:smanchester@universalengineering.com)  
Website: [www.universalengineering.com](http://www.universalengineering.com)



**UNIVERSAL ENGINEERING SCIENCES, INC.**  
3532 Maggie Blvd. | Orlando, FL 32811  
Tel: (407) 423-0504 | Fax: (407) 423-3106

**From:** Susan Manchester  
**Sent:** Monday, November 11, 2019 7:49 AM  
**To:** David Olivieri <DOlivieri@universalengineering.com>  
**Cc:** CobiPermits <CobiPermits@universalengineering.com>; Benjamin Suriel <BSuriel@universalengineering.com>; Michael Weston <mweston81@gmail.com>  
**Subject:** RE: 5108 Mortier Ave - Shed permit 2019-11-018 cannot be approved as submitted - By Owner Michael Weston

Hello David,

Can you please call Michael and explain to him why we need the plans in the format that has been requested?

Mike Weston

321-615-7858

Thank you,

**UES will be open regular business hours on Monday, November 11, 2019**  
**Inspections will also be scheduled and performed status quo**



*Susan Manchester*

Permit Administration for the City of Belle Isle  
Building Inspections and  
Code Compliance Department  
407-423-0504 X23309 or 407-581-8161 option permits  
E-mail: [smanchester@universalengineering.com](mailto:smanchester@universalengineering.com)  
Website: [www.universalengineering.com](http://www.universalengineering.com)



**UNIVERSAL ENGINEERING SCIENCES, INC.**  
3532 Maggie Blvd. | Orlando, FL 32811  
Tel: (407) 423-0504 | Fax: (407) 423-3106

**From:** Michael Weston [<mailto:mweston81@gmail.com>]  
**Sent:** Friday, November 8, 2019 5:31 PM  
**To:** Susan Manchester <[SManchester@universalengineering.com](mailto:SManchester@universalengineering.com)>  
**Cc:** CobiPermits <[CobiPermits@universalengineering.com](mailto:CobiPermits@universalengineering.com)>; Benjamin Suriel <[BSuriel@universalengineering.com](mailto:BSuriel@universalengineering.com)>  
**Subject:** Re: 5108 Mortier Ave - Shed permit 2019-11-018 cannot be approved as submitted - By Owner Michael Weston

Ben / Susan,

What exactly is the issue with the first set of plans? They are master plans for Lee county, which is in a much higher wind speed zone according to the Florida building code when compared to Belle Isle. They are not address specific plans and are intended for repetitive use. They are also 2017 code compliant.

If the issue is you are having trouble reading it, I will go get them printed on a plotter and drop them off at your office.

Let me know. Otherwise, I will submit the app with the same plans, which are intended for repetitive use, and are not address specific.

Mike Weston  
321-615-7858

On Fri, Nov 8, 2019 at 3:43 PM Susan Manchester <[SManchester@universalengineering.com](mailto:SManchester@universalengineering.com)> wrote:

***Please make sure all email is forwarded/replied/sent not only to the sender but ALSO to [cobipermits@universalengineering.com](mailto:cobipermits@universalengineering.com)***

***Otherwise – your payment or info may not get processed***

Hello Michael,

Our plans examiner Ben Suriel has reviewed the second set of plans that you submitted. He was unable to approve the first set and he cannot approve these, either.

These plans were drawn for and already reviewed for another address. I have been advised they need to be address specific. Attached are some additional comments from Ben. These are being included as an advisory only as to what must appear on the new set of plans that must be submitted – address specific and signed and sealed with a wet signature.

When you submit the new plans – please make sure they are accompanied by the application that is attached. We reviewed these plans as a courtesy without the app – but all further submittals must include the completed application.

Thank you,

**UES will be open regular business hours on Monday, November 11, 2019**

**Inspections will also be scheduled and performed status quo**



*Susan Manchester*

Permit Administration for the City of Belle Isle

Building Inspections and

Code Compliance Department

407-423-0504 X23309 or 407-581-8161 option permits

E-mail: [smanchester@universalengineering.com](mailto:smanchester@universalengineering.com)

Website: [www.universalengineering.com](http://www.universalengineering.com)






**UNIVERSAL ENGINEERING SCIENCES, INC.**

3532 Maggie Blvd. | Orlando, FL 32811

Tel: (407) 423-0504 | Fax: (407) 423-3106

--

Mike Weston  
321.615.7858

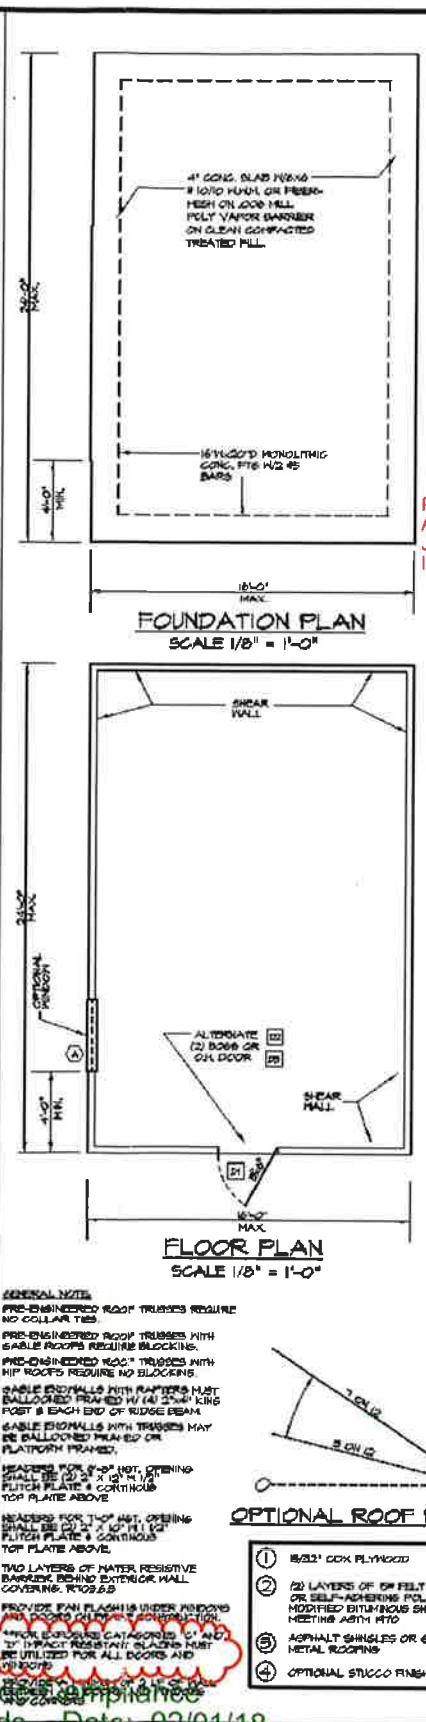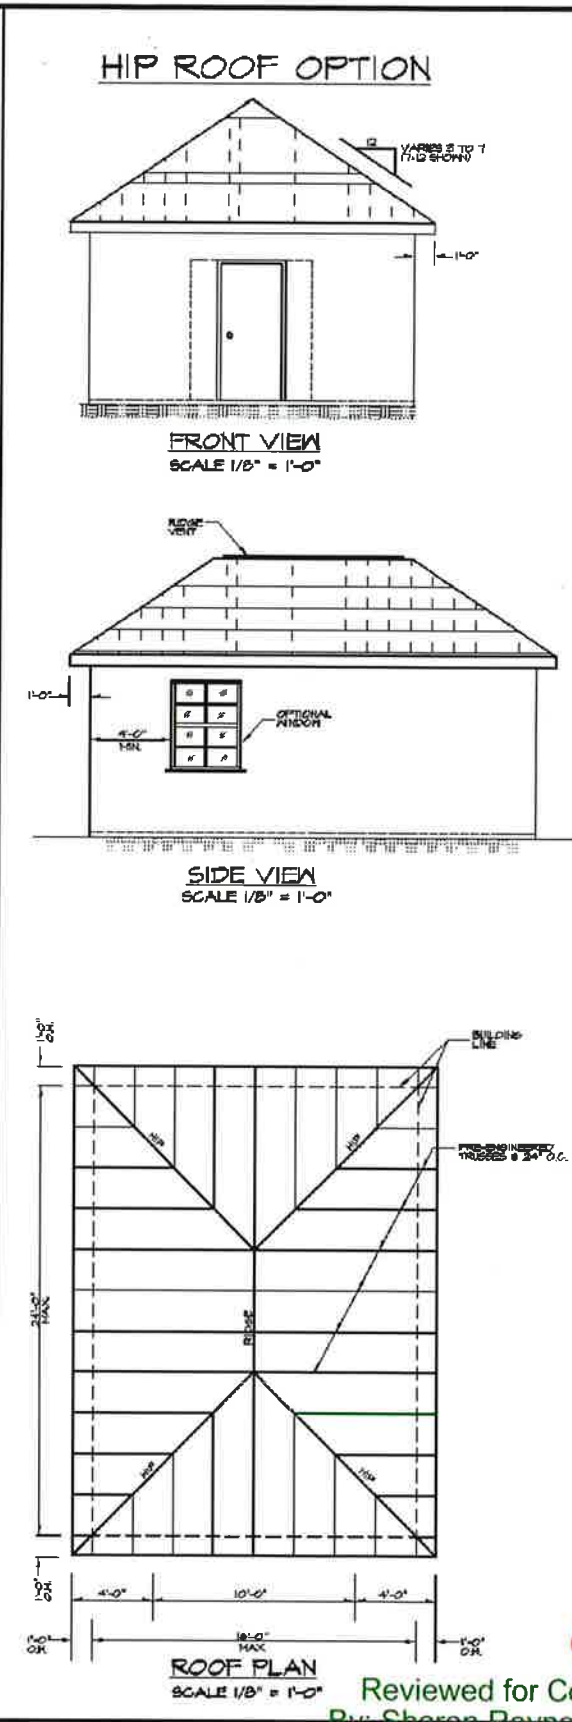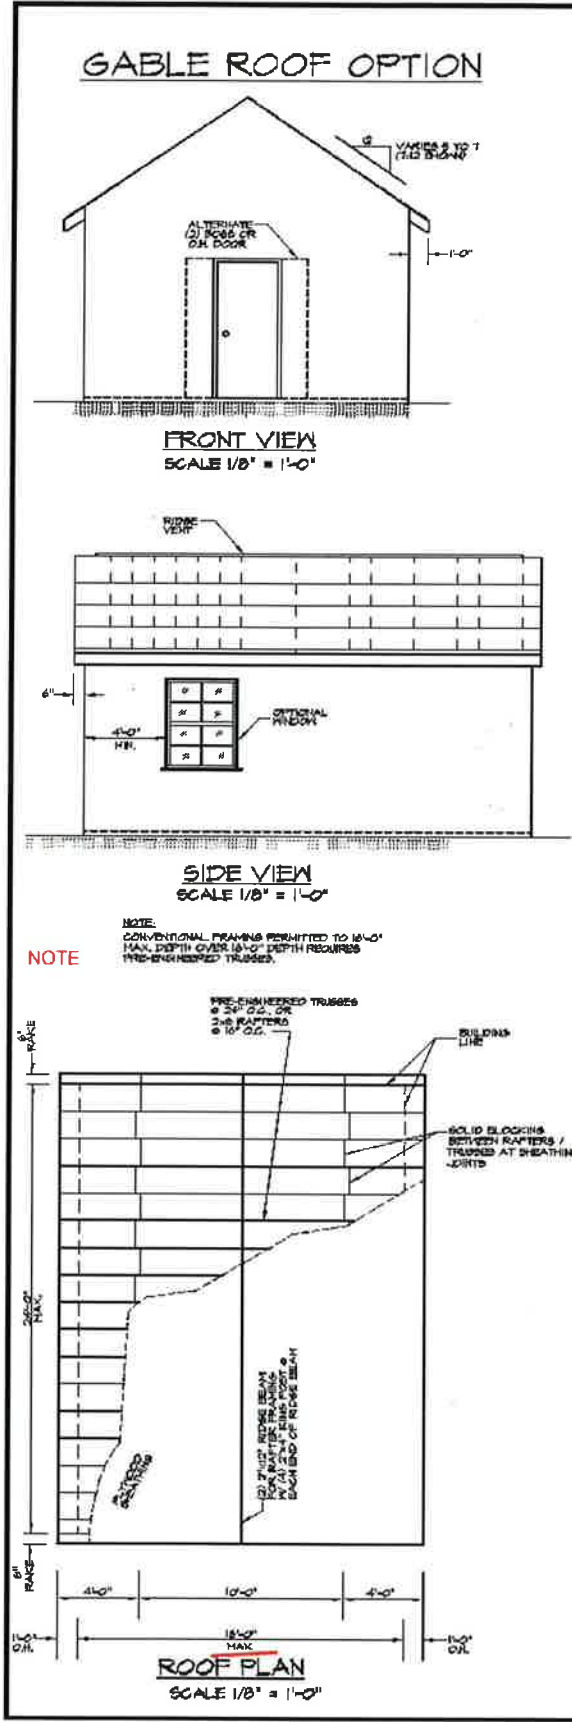

**DESIGN PARAMETERS:**

**APPLICABLE CODES:**

- 2017 FLORIDA BUILDING CODE, RESIDENTIAL, SIXTH EDITION
- 2017 FLORIDA BUILDING CODE, MECHANICAL, SIXTH EDITION
- 2017 FLORIDA BUILDING CODE, PLUMBING, SIXTH EDITION
- 2017 FLORIDA BUILDING CODE, ENERGY CONSERVATION, SIXTH EDITION
- 2017 FLORIDA BUILDING CODE, ACCESSIBILITY, SIXTH EDITION
- FLORIDA FIRE PROTECTION CODE, SIXTH EDITION
- 2014 NATIONAL ELECTRICAL CODE
- NATIONAL FIRE PROTECTION CODE, NFPA 101 (LIFE SAFETY)

**BUILDING OCCUPANCY CLASSIFICATION:**

- GROUP A - ASSEMBLY
- GROUP B - BUSINESS
- GROUP C - DAY CARE CENTER
- GROUP D - EDUCATIONAL
- GROUP E - FACTORY INDUSTRIAL
- GROUP F - HAZARDOUS
- GROUP I - INSTITUTIONAL
- GROUP M - MERCANTILE
- GROUP R - RESIDENTIAL
- GROUP S - STORAGE

**BUILDING CONSTRUCTION TYPE:**

- TYPE I-A
- TYPE I-B
- TYPE I-C
- TYPE II-A
- TYPE II-B
- TYPE II-C
- TYPE III-A
- TYPE III-B
- TYPE V-B

**RISK CATEGORY:**

- I
- II
- III
- IV

**WIND SPEEDS:**

- 60 MPH MINIMUM DESIGN WIND SPEED (3-SECOND GUST)
- 15 MPH MINIMUM DESIGN WIND SPEED (MINUTE 3-MILE)

**SURFACE ROUGHNESS CATEGORY:**

- B
- C
- D

**EXPOSURE CATEGORY:**

- B
- C
- D

**HURRICANE DESIGN REGION:**

- YES
- NOT APPLICABLE FOR B-REDS UNDER 720 SQ FT

**INTERNAL PRESSURE COEFFICIENTS:**

- 0.00 (OPEN)
- +0.15, -0.18 (ENCLOSED)
- +0.25, -0.25 (PARTIALLY ENCLOSED)

**COMPONENTS AND CLADDING PRESSURES:**

- ZONE I: +0.11 / -0.14
- ZONE II: +0.21 / -0.18
- ZONE III: +0.25 / -0.18
- ZONE IV: +0.40 / -0.14
- ZONE V: +0.40 / -0.18

**SECTECHNICAL INFO:**  
FOUNDATIONS ARE BASED ON A MINIMUM SOIL BEARING CAPACITY OF 2000 PSF.

**WINDON SCHEDULE**

KEY	SIZE	TYPE	OPERING	MANUFACTURER	ACTUAL APPLIED WIND PRESSURES	MANUF. MAX. DESIGN PRESSURES	OFFICE PROVISION TYPE OF OPERING PROTECTION (SLASING)	INSTALLATION NOTES	SECT. DETAIL	STATE OF FLORIDA PRODUCT APPROVAL NUMBER
(A)	VARIES	SL	VARIES	SEE STATE APPROVED LIST	44	VARIES	VARIES	N/A	SEE DETAIL	VARIES

**DOOR SCHEDULE**

KEY	SIZE	TYPE	OPERING	MANUFACTURER	ACTUAL APPLIED WIND PRESSURES	MANUF. MAX. DESIGN PRESSURES	OFFICE PROVISION TYPE OF OPERING PROTECTION (SLASING)	INSTALLATION NOTES	SECT. DETAIL	STATE OF FLORIDA PRODUCT APPROVAL NUMBER
(1)	6'-0"	DBS	8'-0" x 6'-0"	SEE STATE APPROVED LIST	44	VARIES	VARIES	N/A	SEE DETAIL	VARIES
(2)	6'-0"	DBS	8'-0" x 6'-0"	SEE STATE APPROVED LIST	44	VARIES	VARIES	N/A	SEE DETAIL	VARIES
(3)	VARIES	DBS	VARIES	SEE STATE APPROVED LIST	44	VARIES	VARIES	N/A	SEE DETAIL	VARIES

**ROOF COVERING MATERIAL**

TYPE	MANUFACTURER	APPROVED MODEL, STYLE OR DESIGNATION
APPROVAL SHOWN ON DRAWING	SEE APPROVED LIST	SEE APPROVED LIST

**SOFFIT COVERING MATERIAL**

TYPE	MANUFACTURER	APPROVED MODEL, STYLE OR DESIGNATION
VARIES	SEE APPROVED LIST	SEE APPROVED LIST

**INITIATION NOTES:**


1. HENK OF EXPOSED
2. TYPED HENK
3. GALV. ENAMEL DOOR
4. BRASS FOR THE DOOR

**LOADS:**

- DS = DECK DESIGNATION
- RL = ROOF DESIGNATION
- FN = FLOOR DESIGNATION

**SIZE DESIGNATIONS:**

- N = NORTH
- H = HENK

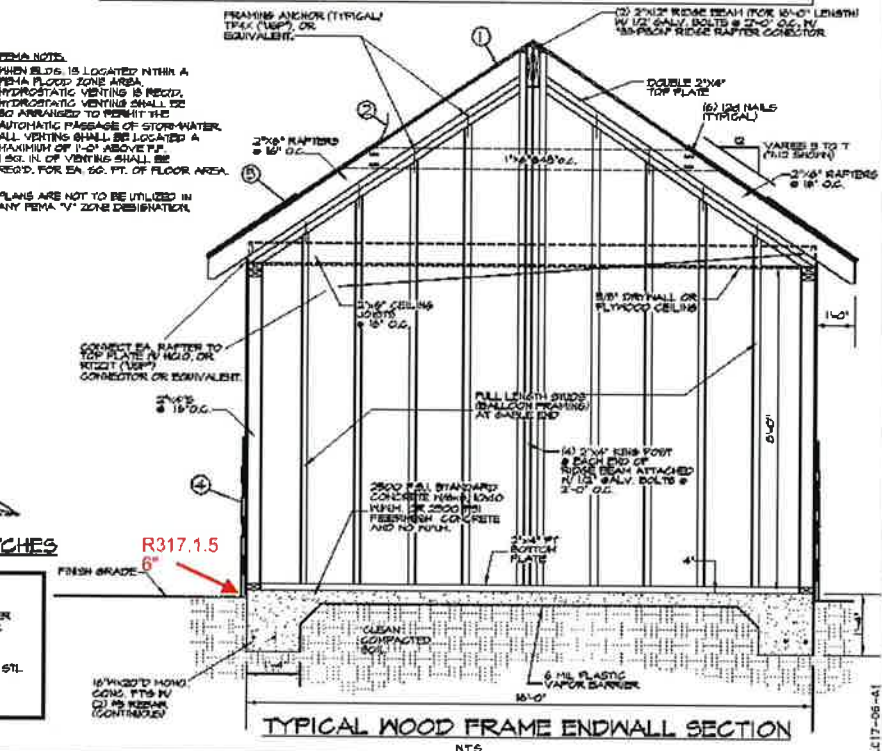

**GENERAL NOTE:**  
PRE-ENGINEERED ROOF TRUSSES REQUIRE NO COLLAR TIES.  
PRE-ENGINEERED ROOF TRUSSES WITH GABLE ROOFS REQUIRE BLOCKING.  
PRE-ENGINEERED ROOF TRUSSES WITH HIP ROOFS REQUIRE NO BLOCKING.  
GABLE ENDWALLS WITH RAFTERS MUST BE BALLOWED THROUGH BY (2) 2x4 KING POSTS AT EACH END OF RIDGE BEAM.  
GABLE ENDWALLS WITH TRUSSES MAY BE BALLOWED THROUGH OR PLATFORTH TRUSSES.  
HEADERS FOR 1'-0" INT. OPENING SHALL BE (2) 2x12 OR (2) 2x10 FLITCH PLATE & CONTINUOUS TOP PLATE ABOVE.  
HEADERS FOR 1'-0" INT. OPENING SHALL BE (2) 2x12 OR (2) 2x10 FLITCH PLATE & CONTINUOUS TOP PLATE ABOVE.  
TWO LAYERS OF WATER RESISTIVE BARRIER BEHIND EXTERIOR WALL COVERING. RTO'S.  
PROVIDE FAN FLASHING UNDER WINDOW AND DOOR CASING FOR PROTECTION.  
\*WIND RESISTANT GLAZING MUST BE UTILIZED FOR ALL DOORS AND WINDOWS.

PRODUCT APPROVAL ON JOB SITE FOR INSPECTIONS

BUILDINGS OVER 720 SQ FT MUST HAVE PROTECTED OPENINGS

LEE COUNTY DEPARTMENT OF COMMUNITY DEVELOPMENT  
DIVISION OF CODES AND BUILDING SERVICES  
HURRICANE RESISTANT RESIDENTIAL CONSTRUCTION  
PURSUANT TO 2017 FLORIDA BUILDING CODE

**16' WIDE WOOD FRAME STORAGE BUILDING**



Robert W. Case, P.E.  
cn=Robert W. Case, P.E., o=LIS Engineering, LLC, ou,  
email=BOBC@LIS-ENGINEERING.COM, c=US  
2018.01.17  
00'05- 10:37:00  
11.0.23

Reviewed for Code Compliance  
By: Sharon Reynolds Date: 02/01/18  
RESMSTR18-0004

SCALE: AS NOTED  
DATE: DECEMBER 11, 2017  
SHEET **A1**



**STORAGE BUILDING**

**GENERAL**

- The building/structure has been designed in accordance with the Sixth Edition of the 2017 Florida Building Codes, and Section 1604 for design pressures generated by a three second gust design wind velocity of 150 mph (116 mph fastest mile wind velocity). Structural calculations, including gravity loads, as necessary to confirm compliance with the Sixth Edition of the 2017 Florida Building Codes, have been performed.
- The owner, his agent, or general contractor is responsible for field supervision, construction administration, review and approval of all shop drawings, verification on-site of all dimensions and elevations, and strict compliance with these construction documents as approved by Lee County. These plans are intended to be mastered. The repetitive use of these plans for permitting is approved.
- All windows, doors, and other such systems, components and cladding shall be designed in accordance with Section 1604 of the Sixth Edition of the 2017 Florida Building Code for design pressures generated by a three second gust design wind velocity of 150 mph (116 mph fastest mile wind velocity), see "Design Parameters" for specific pressures.

**FASTENERS & CONNECTORS**

- Approved connectors, anchors and other fastening devices not included in the Florida Building Code shall be installed in accordance with the manufacturer's recommendations.
- Where fasteners are not otherwise specified fasteners shall be provided in accordance with Table 2304.4.1 of the Sixth Edition of the 2017 Florida Building Code. Nails, screws, or bolts shall be able to resist the forces in this Code.
- Unless otherwise stated, sizes given for nails are common wire nails. For example, 3d = 2 1/2 inches long x 0.131-inch diameter. See Table 12.2B, columns 2, 3, and 4, in the National Design Specifications for Wood Construction. Metal plates, connectors, screws, bolts and nails exposed directly to the weather or subject to salt corrosion in coastal areas, as determined by the Building Official, shall be stainless steel, or hot dipped galvanized after the fastener or connector is fabricated to a zinc coating not less than 1 oz per sq ft, or hot dipped galvanized with a minimum coating of 1.0 oz per sq ft of steel meeting the requirements of ASTM A 10 Triple Spot Test.

**FOOTINGS AND FOUNDATIONS**

**GENERAL**

- All exterior walls, bearing walls, columns, and piers shall be supported on continuous concrete footings, piles, or other approved structural systems which shall be a sufficient design to support safely the loads imposed as determined from the character of the soil. Refer to standard details for typical foundation details.
- Fill shall be placed and compacted in one foot lifts.
- Concrete shall have a minimum specified compressive strength of 3000 psi at 28 days.
- Reinforcing Steel shall be minimum grade 40 and identified in accordance with ASTM A 615, A 616, A 617, or A 706.
- Metal Accessories: Joint reinforcement, anchors, ties, and wire fabric shall conform to the following standards:
  - ASTM 92 for joint reinforcement and wire anchors and ties.
  - ASTM 36 for plate, headed and bent bar anchors.
  - ASTM 306 for sheet metal anchors and ties.
- Metal accessories for use in interior wall construction shall be mill galvanized in accordance with ASTM A 641, Class 1.
- Minimum concrete cover over reinforcing bars shall be 3 inches. In narrow footings where insufficient which is available to accommodate a standard 90 degree hook and provide the required concrete cover, the hook shall be rotated in the horizontal direction until the required concrete cover is achieved.
- Masonry units shall be hollow or solid concrete units in accordance with ASTM C 90 or C 145 and shall have a minimum net area compressive strength of 1900 psi.
- Mortar shall be either Type M or S in accordance with ASTM C 270.
- Grout shall have a maximum coarse aggregate size of 3/8 inch placed at an 8 to 11 inch slump and have a minimum specified compressive strength of 2,000 psi at 28 days when tested in accordance with ASTM C 1018, or shall be in accordance with ASTM C 476.
- All mortar joints for hollow unit masonry shall extend the full width of face shells. Mortar joints for solid masonry shall be full head and bed joints.
- Bed joints shall be 3/8 inch (7/8 1/8 inch) thick. Head joints shall be 3/8 inch x 3/8 inch or -
- The bed joint of the starting course placed over footings shall be permitted to vary in thickness from a minimum of 1/4 inch to a maximum of 3/4 inch.
- Masonry walls shall be running bond or stack bond construction. Walls of stack bond construction, in addition to required vertical reinforcement, shall be provided with a minimum of 4 gage horizontal joint reinforcement placed in bed joints not more than 16 inches on center.
- Longitudinal wires of joint reinforcement shall be fully embedded in mortar or grout with a minimum cover of 3/8 inch when exposed to earth or weather and 1/2 inch when not exposed to earth or weather.
- Reinforcing bar used in masonry walls shall have a masonry cover (including grout) not less than 2 inches.
- All concrete to be mixed, transported, and placed in accordance with the latest ACI Specifications and Recommendations.
- Foundations have been designed for an allowable soil bearing pressure of 2,000 PSF, and the existing soil being a granular material should poor soil conditions be found it is the contractor's responsibility to notify the engineer prior to commencing.
- Provide granular fill, clay materials are unacceptable. Existing soil under footing and slabs shall be compacted to 95% of AASHTO T-99.
- Provide (1) #5 electrical ground to foundation steel.
- A 6 mil minimum polyethylene damp-proofing vapor barrier shall be provided, per FBC R320.1.4 and R506.2.3.
- Fill shall be termite treated and a "Certificate for Termite Treatment" is required on the permit board pursuant to FBC Sec. 105.10 and FBC R320.1.
- All footings shall be a minimum of 12" below finished grade.
- The top of slab shall be a minimum of 8" above finished grade for wood frame construction.
- The top of slab shall be a minimum of 4" above finished grade for masonry veneer and a minimum of 6" elsewhere.

**CONCRETE FLOORS**

- Concrete floors shall be cast in place.
- Concrete shall have a minimum compressive strength of not less than 3000 psi at 28 days.
- The top of a monolithic slab-on-grade shall be at least 3 inches above finished grade.
- The slab shall be 4 inches thick.
- The slab shall have 6x6 No. 10 welded wire fabric at mid-height or synthetic fiber reinforcement.
- A double layer of welded wire fabric shall be provided around the perimeter of the slab at a distance of 9 ft. from the edge. See Standard Details.

- Welded wire fabric shall conform to ASTM A-105 and free of oil and rust. It shall be installed in lengths as long as possible lapped a minimum of six inches.

**WOOD GENERAL**

- All wood construction shall comply with the latest NFPA and AITC Specifications and Recommendations.
- Lumber standard shall be American Softwood Lumber Standard PS 20-10, 5-6, 5-8, 19% moisture or as required by structural design.
- Structural lumber (roof beams, headers, columns, exterior wall studs to be Southern Pine No. 2 KD 15 with a Fb=1,900 PSI, E=1,600,000 PSI, and Fv = 175 PSI.
- Blue laminated timber shall conform with ASTM D-2797 and AITC 117. Roof beams shall be designated 24F-V1 or 24F-E1.
- Flywood for sheathing shall be APA rated sheathing as per plans and shall bear the APA Mark.
- Wood in contact with concrete, masonry and/or exposed to weather shall be protected or pressure treated in accordance with AITC-109.

**EXTERIOR WALL FRAMING**

- Studs shall be placed with the wide face perpendicular to the wall.
- Header Beams shall be provided and sized in accordance with Section R602.7, of the Sixth Edition of the 2017 Florida Building Code.
- The minimum number of header studs supporting each end of a header beam shall be 2.
- The minimum number of full-length wall studs of each end of a header beam shall be 2 for openings of 6 feet or less, and 3 feet for all other openings.
- Uplift connectors shall be provided at the top and bottom of cripple studs, of header studs, and at least one wall stud at each side of opening.

**CONNECTIONS FOR EXTERIOR WALL FRAMING**

- Framing members in exterior wall systems shall be fastened together in accordance with Section 2305 of the Sixth Edition of the 2017 Florida Building Code.
- Uplift connectors shall be provided to resist the uplift loads.
- Uplift load resistance shall be continuous from roof to foundation.
- Studs shall be connected to plates and plates to floor framing with connectors designed, rated, and approved for each individual location and condition. See Windload Connectors Schedule.
- Where Anchor down connectors occur connectors required for uplift resistance may be omitted.

**EXTERIOR WALLS**

- Exterior wall segments shall not contain openings which when added together will exceed 144 sq ft (1 sq ft) in any individual segment.
- Each corner shall be sheathed for a least 3 feet and may be counted as a shearwall segment.
- Minimum length of a shearwall segment shall be 2'-5". The tops of all shearwall segments in any wall shall be connected by drag struts.
- Studs shall be doubled at each end of each shearwall segment.
- Joints shall be lap-spliced. Within the center third of a wall length, the minimum lap shall be 4 feet. Lap splices shall be connected with 14 16d common nails.
- Provide bridging/blocking at mid-span of exterior wall studs.

**PLYWOOD SHEATHING USED FOR UPLIFT RESISTANCE**

- Panel shall be 15/32" exposure I C-D sheathing grade plywood and shall be installed as follows:
  - Panel shall be installed with face grain parallel to studs.
  - All horizontal joints shall occur over framing and shall be attached per Detail Sheets.
  - Flashing blocking shall be used at all horizontal panel joints.
  - Panel shall be attached to bottom plates and top member of the double top plate.
  - Lowest plates shall be attached to foundation with bolts or connectors of sufficient capacity to resist the uplift forces developed in the plywood sheathed walls.
  - Panel attachment to framing shall be as illustrated in the Detail Sheets.
  - Where windows and doors interrupt plywood sheathing, framing anchors or connectors shall be used to resist the appropriate uplift loads.

**ANCHOR DOWN CONNECTORS**

- Exterior walls require anchor downs to resist overturning moment.
- Two studs and anchor down are required at each end of each shearwall segment.
- The anchor down shall be fastened through the doubled studs and to the construction below in accordance with the manufacturer's recommendations. See Windload Connectors Schedule.

**ROOF & TRUSSES**

**TRUSS FRAMING SYSTEMS**

- Trusses shall be designed in accordance with TPI Design Specification for Metal Plate Connected Wood Trusses.
- Parallel Chord Roof Trusses shall be in accordance with TPI Design Specifications for Metal Plate Connected Parallel Chord Wood Trusses.
- Truss design submittals shall indicate design wind speed, height above ground, and amount of uplift at bearings.
- Metal plate connected wood trusses shall be spaced no more than 24 inches on center and designed for live loads and Windloads for an enclosed building based on Sections 2304.4, R502.11.4, and R602.10, of the Sixth Edition of the 2017 Florida Building Codes.
- Girder trusses shall be designed to function also as drag struts. Truss design submittals and erection instructions shall show both uplift and lateral connection load requirements at end of girder truss.
- Top chords of trusses shall be of Group II species lumber.
- Uplift connectors shall be provided at truss bearing to resist the uplift loads.
- Where trusses are used to form a hipped roof, a stop down hip system shall be used. See detail sheets.
- Provide blocking at ends and mid-spans of roof trusses.
- Roof trusses shall be pre-engineered and designed by a Florida Registered Engineer. Truss manufacturer shall provide shop drawings signed and sealed by a Florida Registered Engineer. Roof trusses shall be placed in accordance with the truss manufacturer's drawings and specifications.

**ROOF SHEATHING**

- Roof sheathing shall be 15/32 inch Exposure I C-D sheathing grade plywood (wood structural panels), or equivalent.
- The sheathing shall be installed in accordance with Detail Sheets.
- Long dimension shall be perpendicular to framing and end joints shall be staggered.
- Sheathing shall be fastened to roof framing with 6d ring-shank nails at 6 inches on center at edges and 6 inches on center in the field. Ring-shank nails shall conform to the Florida Building Code.

- Ring-shank nails shall have the following minimum dimensions:
- 0.115-inch nominal shank diameter
  - Ring diameter of 0.012 over shank diameter
  - 16-20 rings per inch
  - 0.280 inch full round head diameter
  - 2-inch nail length

**Exceptions:**

Where roof diaphragm requirements may necessitate a closer fastener spacing.

**ASPHALT SHINGLE ROOF COVERING**

- Roof coverings shall be applied in accordance with the applicable provisions of FBC Sec. 1507 and the manufacturer's installation instructions.
- The installation of asphalt shingles shall comply with the provisions of FBC Sec. 1507.3.
- Asphalt shingles shall be solidly sheathed decks.
- Asphalt shingles shall be used only on roof slopes of 2:12 or greater. For roof slopes from 2:12 up to 4:12, double underlayment application is required in accordance with ECOTB.6.
- Unless otherwise noted, required underlayment shall conform with ASTM D 226, type 1, or ASTM D 4869, type 1.
- Self-adhering polymer modified bitumen sheet shall comply with ASTM 1910.
- Asphalt shingles shall have self-seal strips or be interlocking, and comply with ASTM D 225 or ASTM D 3462.
- Fasteners for asphalt shingles shall be galvanized, stainless steel, aluminum or copper roofing nails, minimum 12 gauge shank with a minimum 5/8 inch diameter head, of a length to penetrate through the roofing materials and a minimum of 3/4 inch into the roof sheathing. Where the roof sheathing is less than 3/4 inch thick, the nails shall penetrate through the sheathing.
- Asphalt shingles shall be secured to the roof with not less than four fasteners per strip shingle or two fasteners per individual shingle.
- For roof slopes from 2:12 up to 4:12, underlayment shall be a minimum of two layers applied as follows:
  - Starting at the eave, a 19-inch strip of underlayment shall be applied parallel with the eave and fastened sufficiently to stay in place.
  - Starting at the eave, 36-inch-wide strips of underlayment felt shall be applied overlapping successive sheets 19 inches and fastened sufficiently to stay in place.
- For roof slopes 4:12 or greater, underlayment shall be a minimum of one layer of underlayment felt as follows: starting at the eave, underlayment shall be applied shingle fashion parallel to the eave, lapped 2 inches, and fastened sufficiently to stay in place.

**CEILING DIAPHRAGMS**

- In those cases where a gable endwall is not built using full-height studs continuous from floor to roof (balloon framing) a ceiling diaphragm shall be used to resist the lateral loads at the horizontal joint between the top plate of a platform-framed endwall and the gable construction above.
- Where there is no ceiling diaphragm at the height, such as a cathedral ceiling condition, the entire endwall, including the gable, must be constructed using full length studs from the floor to the roof deck (balloon framing), see detail sheets.
- Where a gypsum wallboard ceiling is used to create the required diaphragm, the diaphragm length must be at least two times the width of the building.
- The gypsum board must be a 5/8", of 5/8 inch thick and must be fastened directly to the ceiling joists or bottom chords of trusses (no furring) with 5d cooler nails or 6x3-54 1 1/2 inch nails at 7 inches on center.
- Ceiling framing shall be braced with full depth blocking at 4 feet on center in the first four framing spaces from each end at top and bottom chords.
- Lateral loads at the endwall top plate shall be resisted by connecting the top plate to a 2x ceiling nailer with 10d nails at 6 inches on center. See detail sheets.

**EXTERIOR WALL VENEERS**

- Exterior wall veneers shall be installed in accordance with Section 1405 of the Sixth Edition of the 2017 Florida Building Code.
- Application of stucco (portland cement plaster) shall be in accordance with ASTM C 295, Application of Portland Cement Based Plaster.












WINDLOAD CONNECTORS SCHEDULE				
LABEL	MANUFACTURER	DESCRIPTION	FASTENERS	
1	UD TORS	UD TORS	WOOD TO WOOD UPLIFT CORN ASSY	(4) 3/4" x 8"
2	HTA24	HEA24	TRUSS/WAFFER ANCHOR	10-16d x 1-1/2"
3	TP42	2PM4	TOP/BOTTOM PLATE ANCHORS	10-16d
4	HE3	H3	HURRICANE CLIP	9-10d - 9-10d
5	RT24T	HT32A	TRUSS/WAFFER TIES	10-16d (24-36d 1/2" SPACED STRIPS)
6	TR3	HBR/3	ANCHOR DOWN	10-16d x 8" x 8" - 10-16d x 8"
7	RT30P	LTS30	TRUSS/WAFFER TIES	10-16d
8	21A5	N/A	PLATE UPLIFT CONNECTOR	(2) 3/4" x 8" - (4) 3/4" x 8"
9	HTA20	HEA20	TRUSS ANCHOR, HIGH UPLIFT	16-20d x 1-1/2"
10	PA2	PA2	PURLIN ANCHOR	16-16d
11	HE10-2	H10-2	HURRICANE CLIP	9-10d - 9-10d
12	UDCAF	N/A	TRUSS/WAFFER TIES	(8) 16d - (4) 3/4" x 8"

LEE COUNTY DEPARTMENT OF COMMUNITY DEVELOPMENT  
 DIVISION OF CODES AND BUILDING SERVICES  
 HURRICANE RESISTANT RESIDENTIAL CONSTRUCTION  
 PURSUANT TO 2017 FLORIDA BUILDING CODE

16' WIDE WOOD FRAME  
 STORAGE BUILDING

SCALE: N.T.S.  
 DATE: DECEMBER 11, 2017  
 SHEET  
**N1**

By: Sharon Reynolds Date: 02/01/18

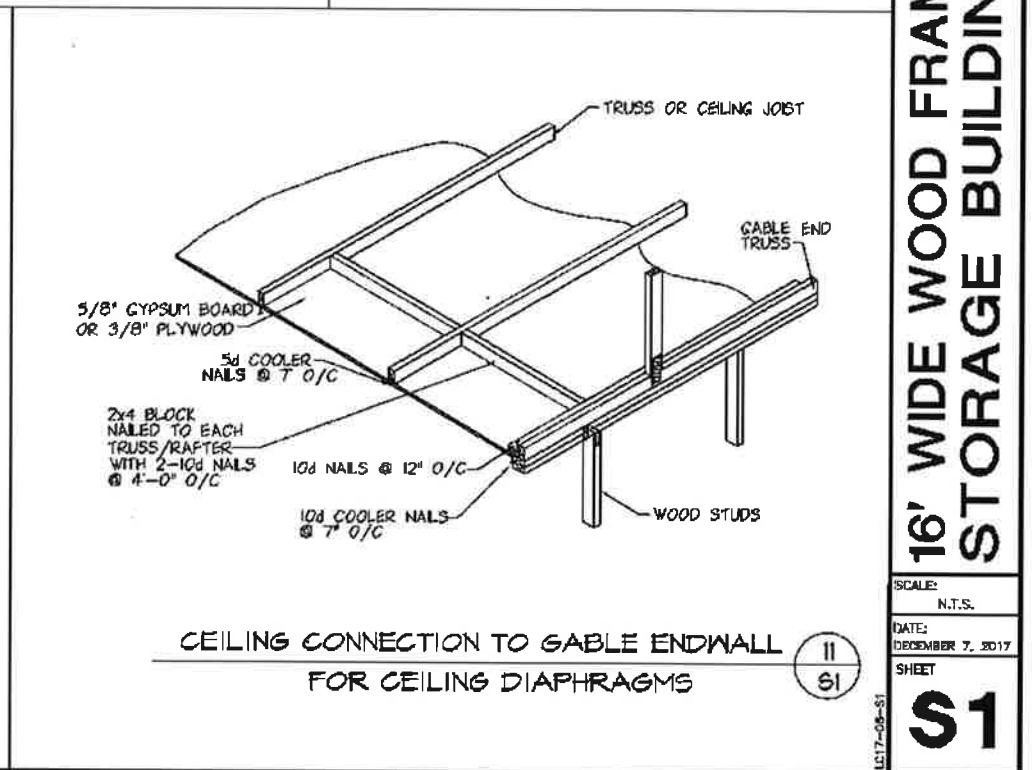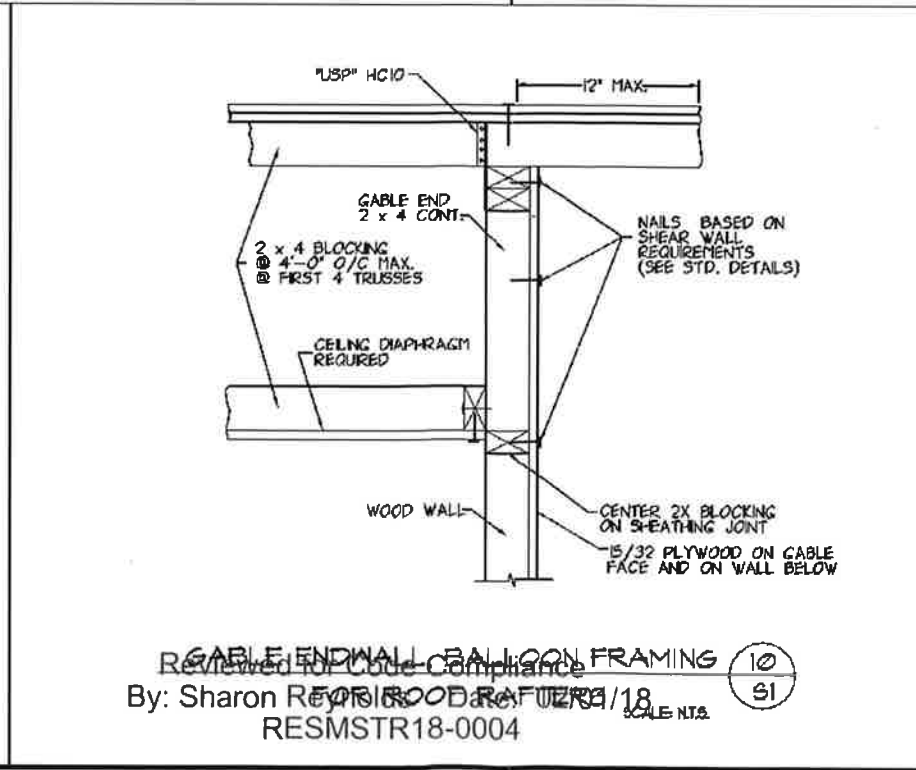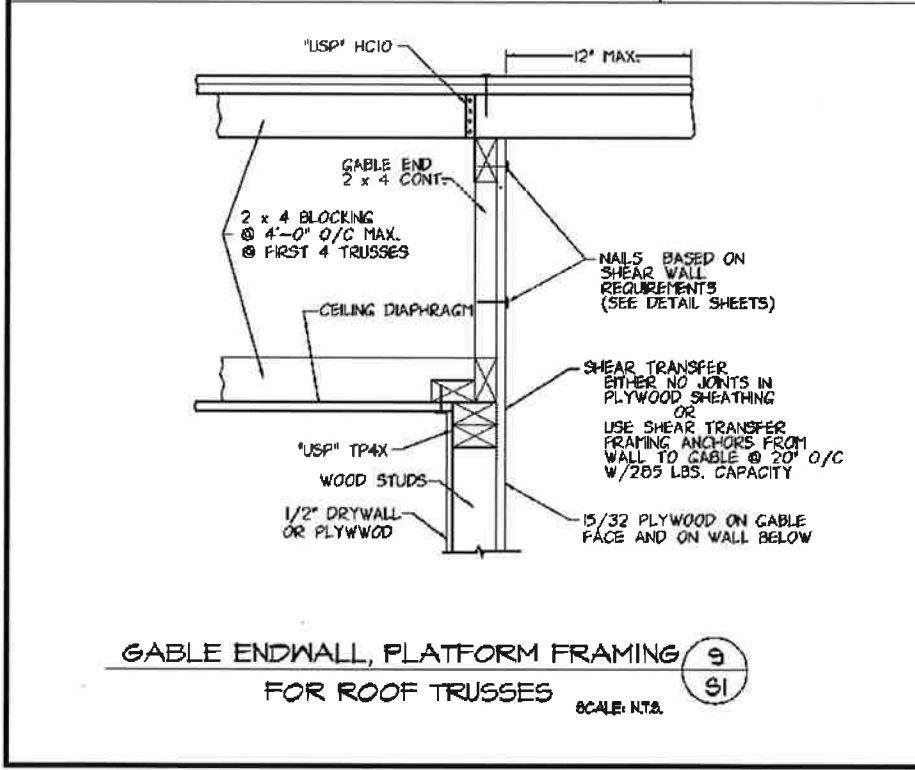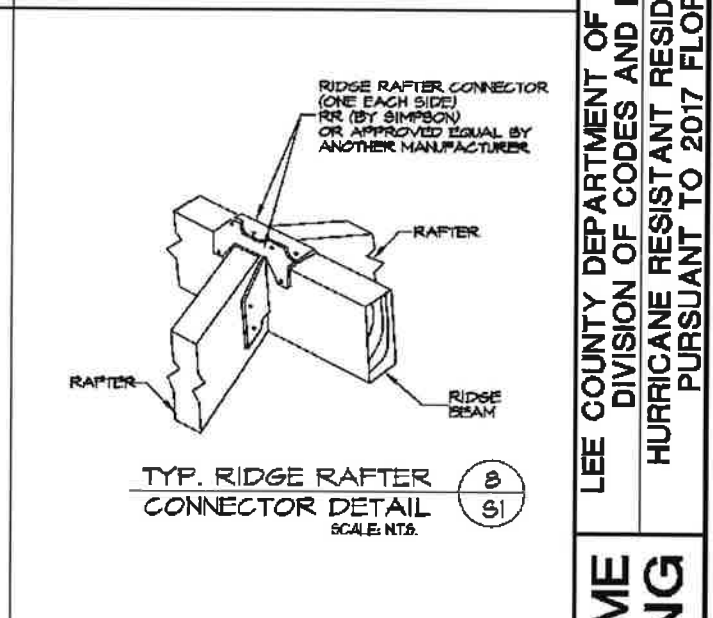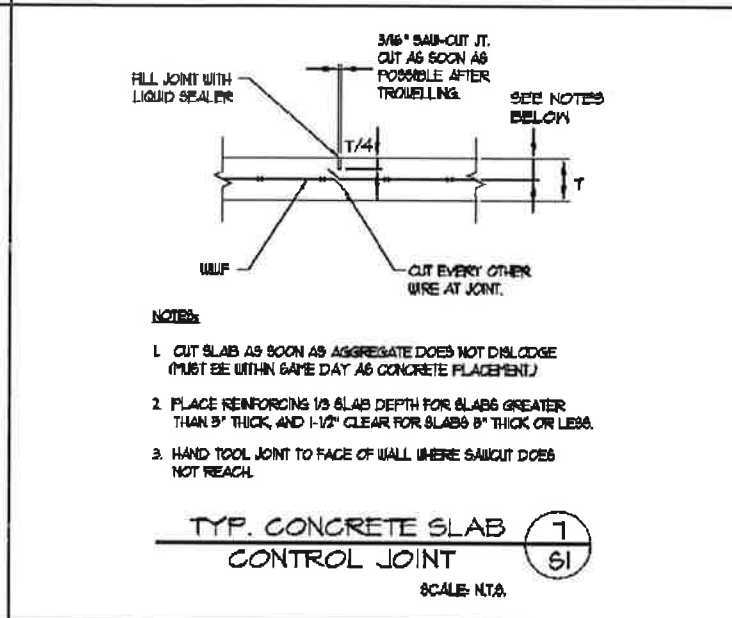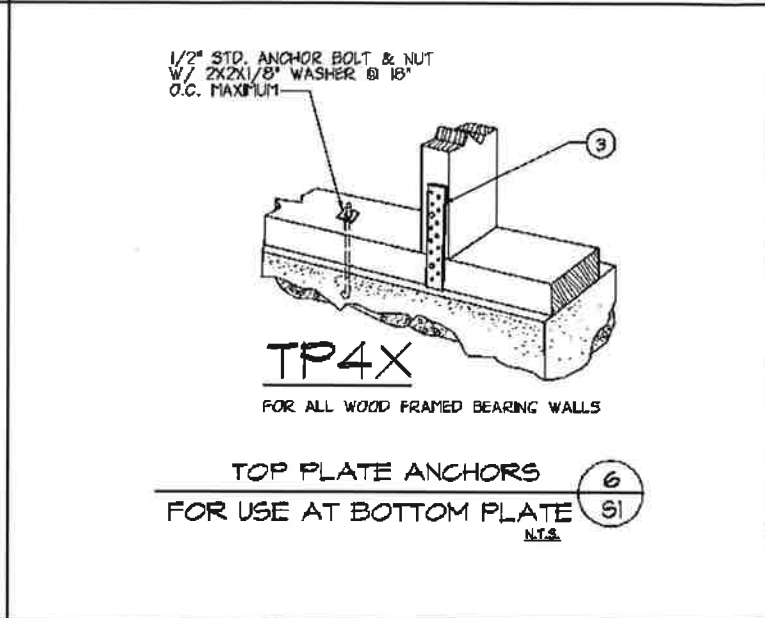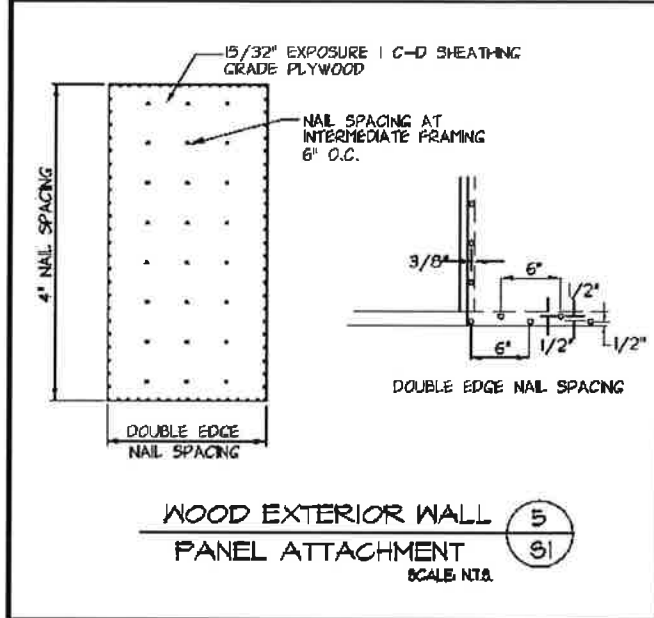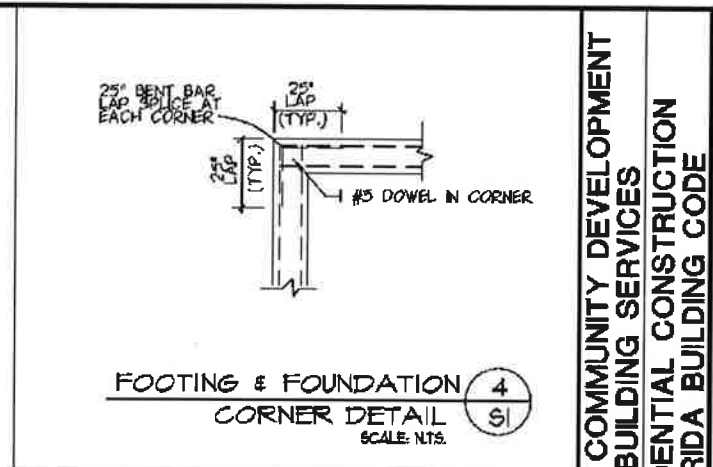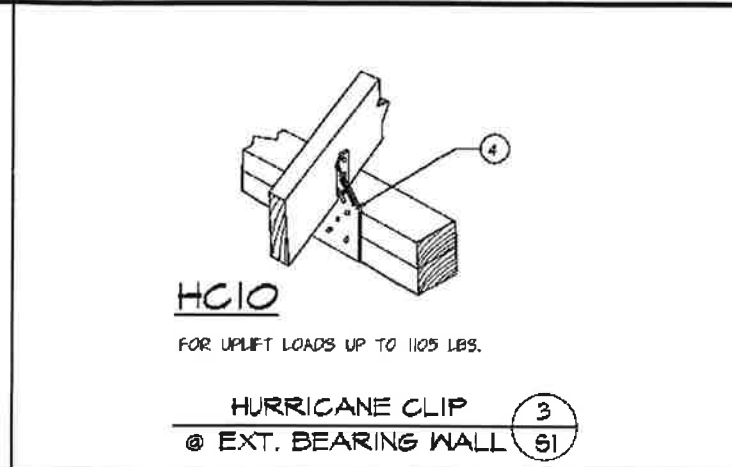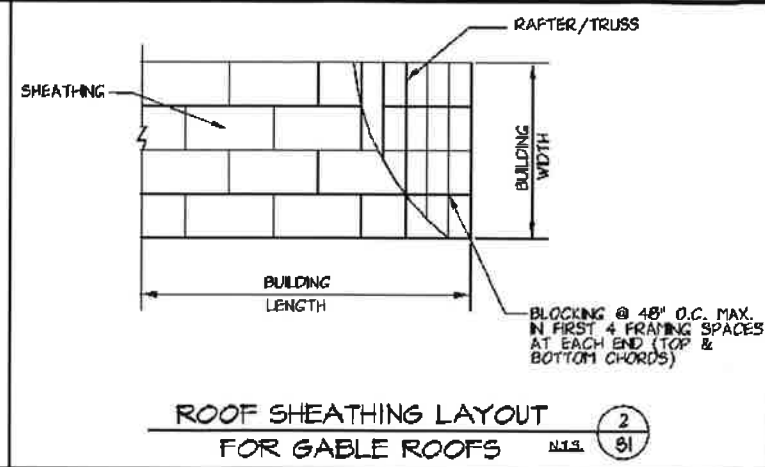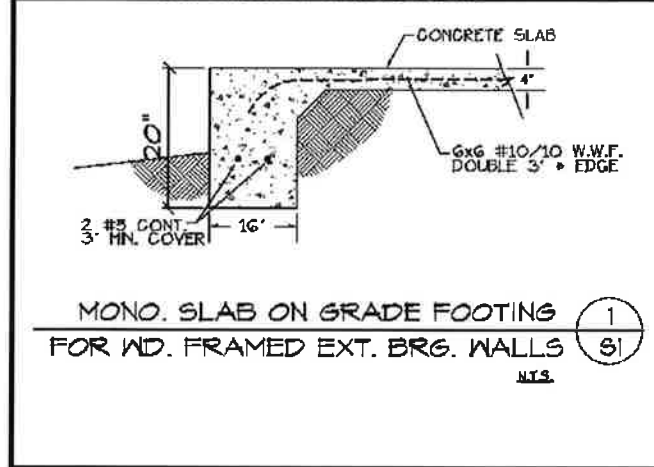


LEE COUNTY DEPARTMENT OF COMMUNITY DEVELOPMENT  
DIVISION OF CODES AND BUILDING SERVICES  
HURRICANE RESISTANT RESIDENTIAL CONSTRUCTION  
PURSUANT TO 2017 FLORIDA BUILDING CODE

**16' WIDE WOOD FRAME STORAGE BUILDING**

SCALE: N.T.S.  
DATE: DECEMBER 7, 2017  
SHEET  
**S1**

Reviewed for Code Compliance  
By: Sharon Reynolds  
Date: 12/7/18  
RESMSTR18-0004


**TDX5**  
FOR USE AT ALL  
CORNERS & OPENINGS

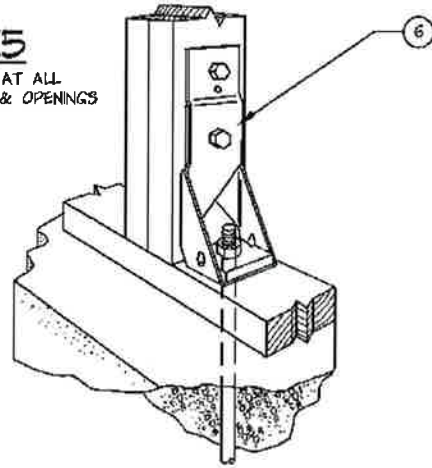


**ANCHOR DOWN** (1)  
N.T.S. (S2)

**TP4X**


FOR USE AT ALL WOOD  
FRAMED BEARING WALLS

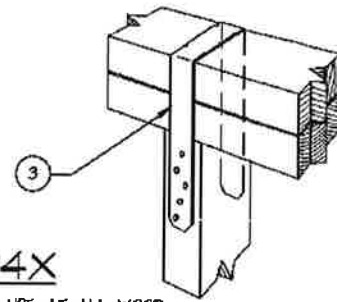

**TOP PLATE ANCHOR** (2)  
N.T.S. (S2)

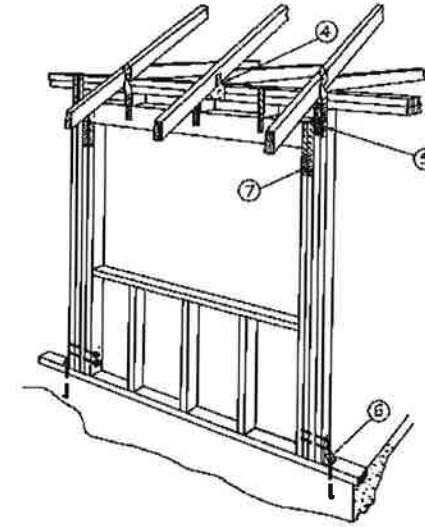


**TYP. HEADER & CONNECTORS FOR** (3)  
**OPENINGS AT EXT. BEARING WALLS** (S2)  
N.T.S.

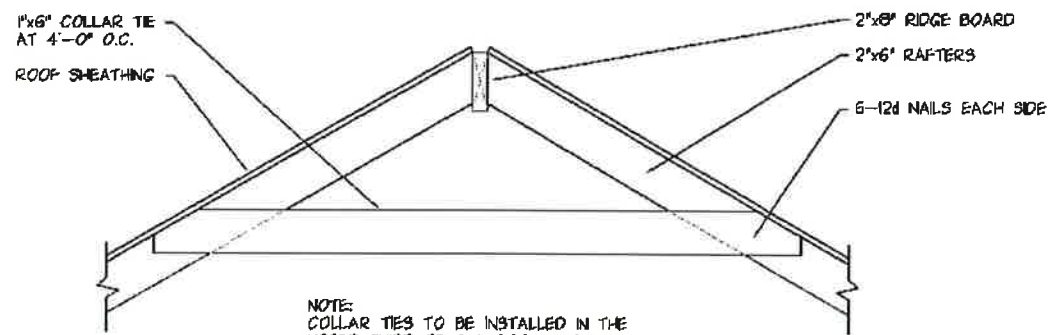

NOTE:  
COLLAR TIES TO BE INSTALLED IN THE  
UPPER THIRD OF THE ROOF HEIGHT

**ROOF BRACING DETAIL** (4)  
N.T.S. (S2)

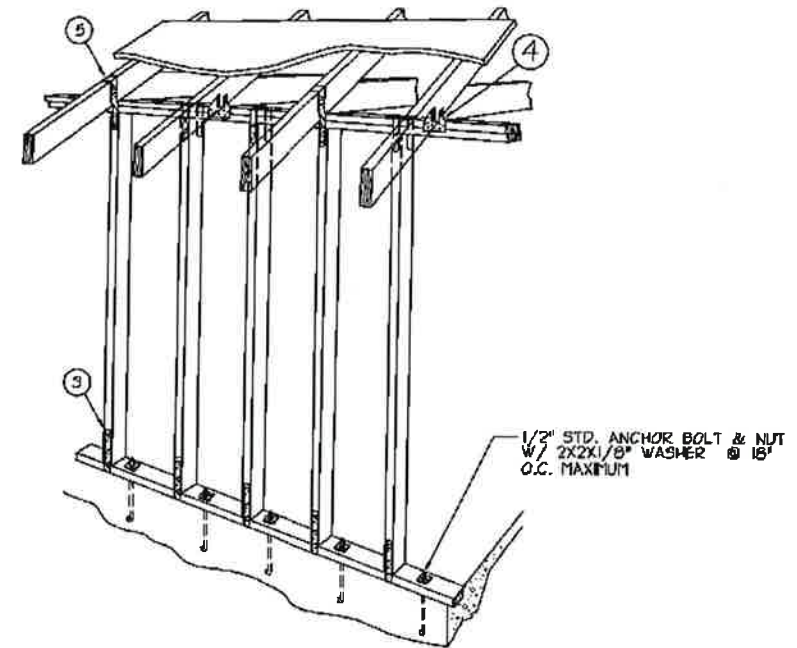

**TYPICAL EXT. WD. FRAME BEARING** (5)  
**WALL CONNECTIONS & STRAPPING** (S2)

Reviewed for Code Compliance  
By: Sharon Reynolds Date: 02/01/18  
RESMSTR18-0004